


VICINITY MAP
NOT TO SCALE

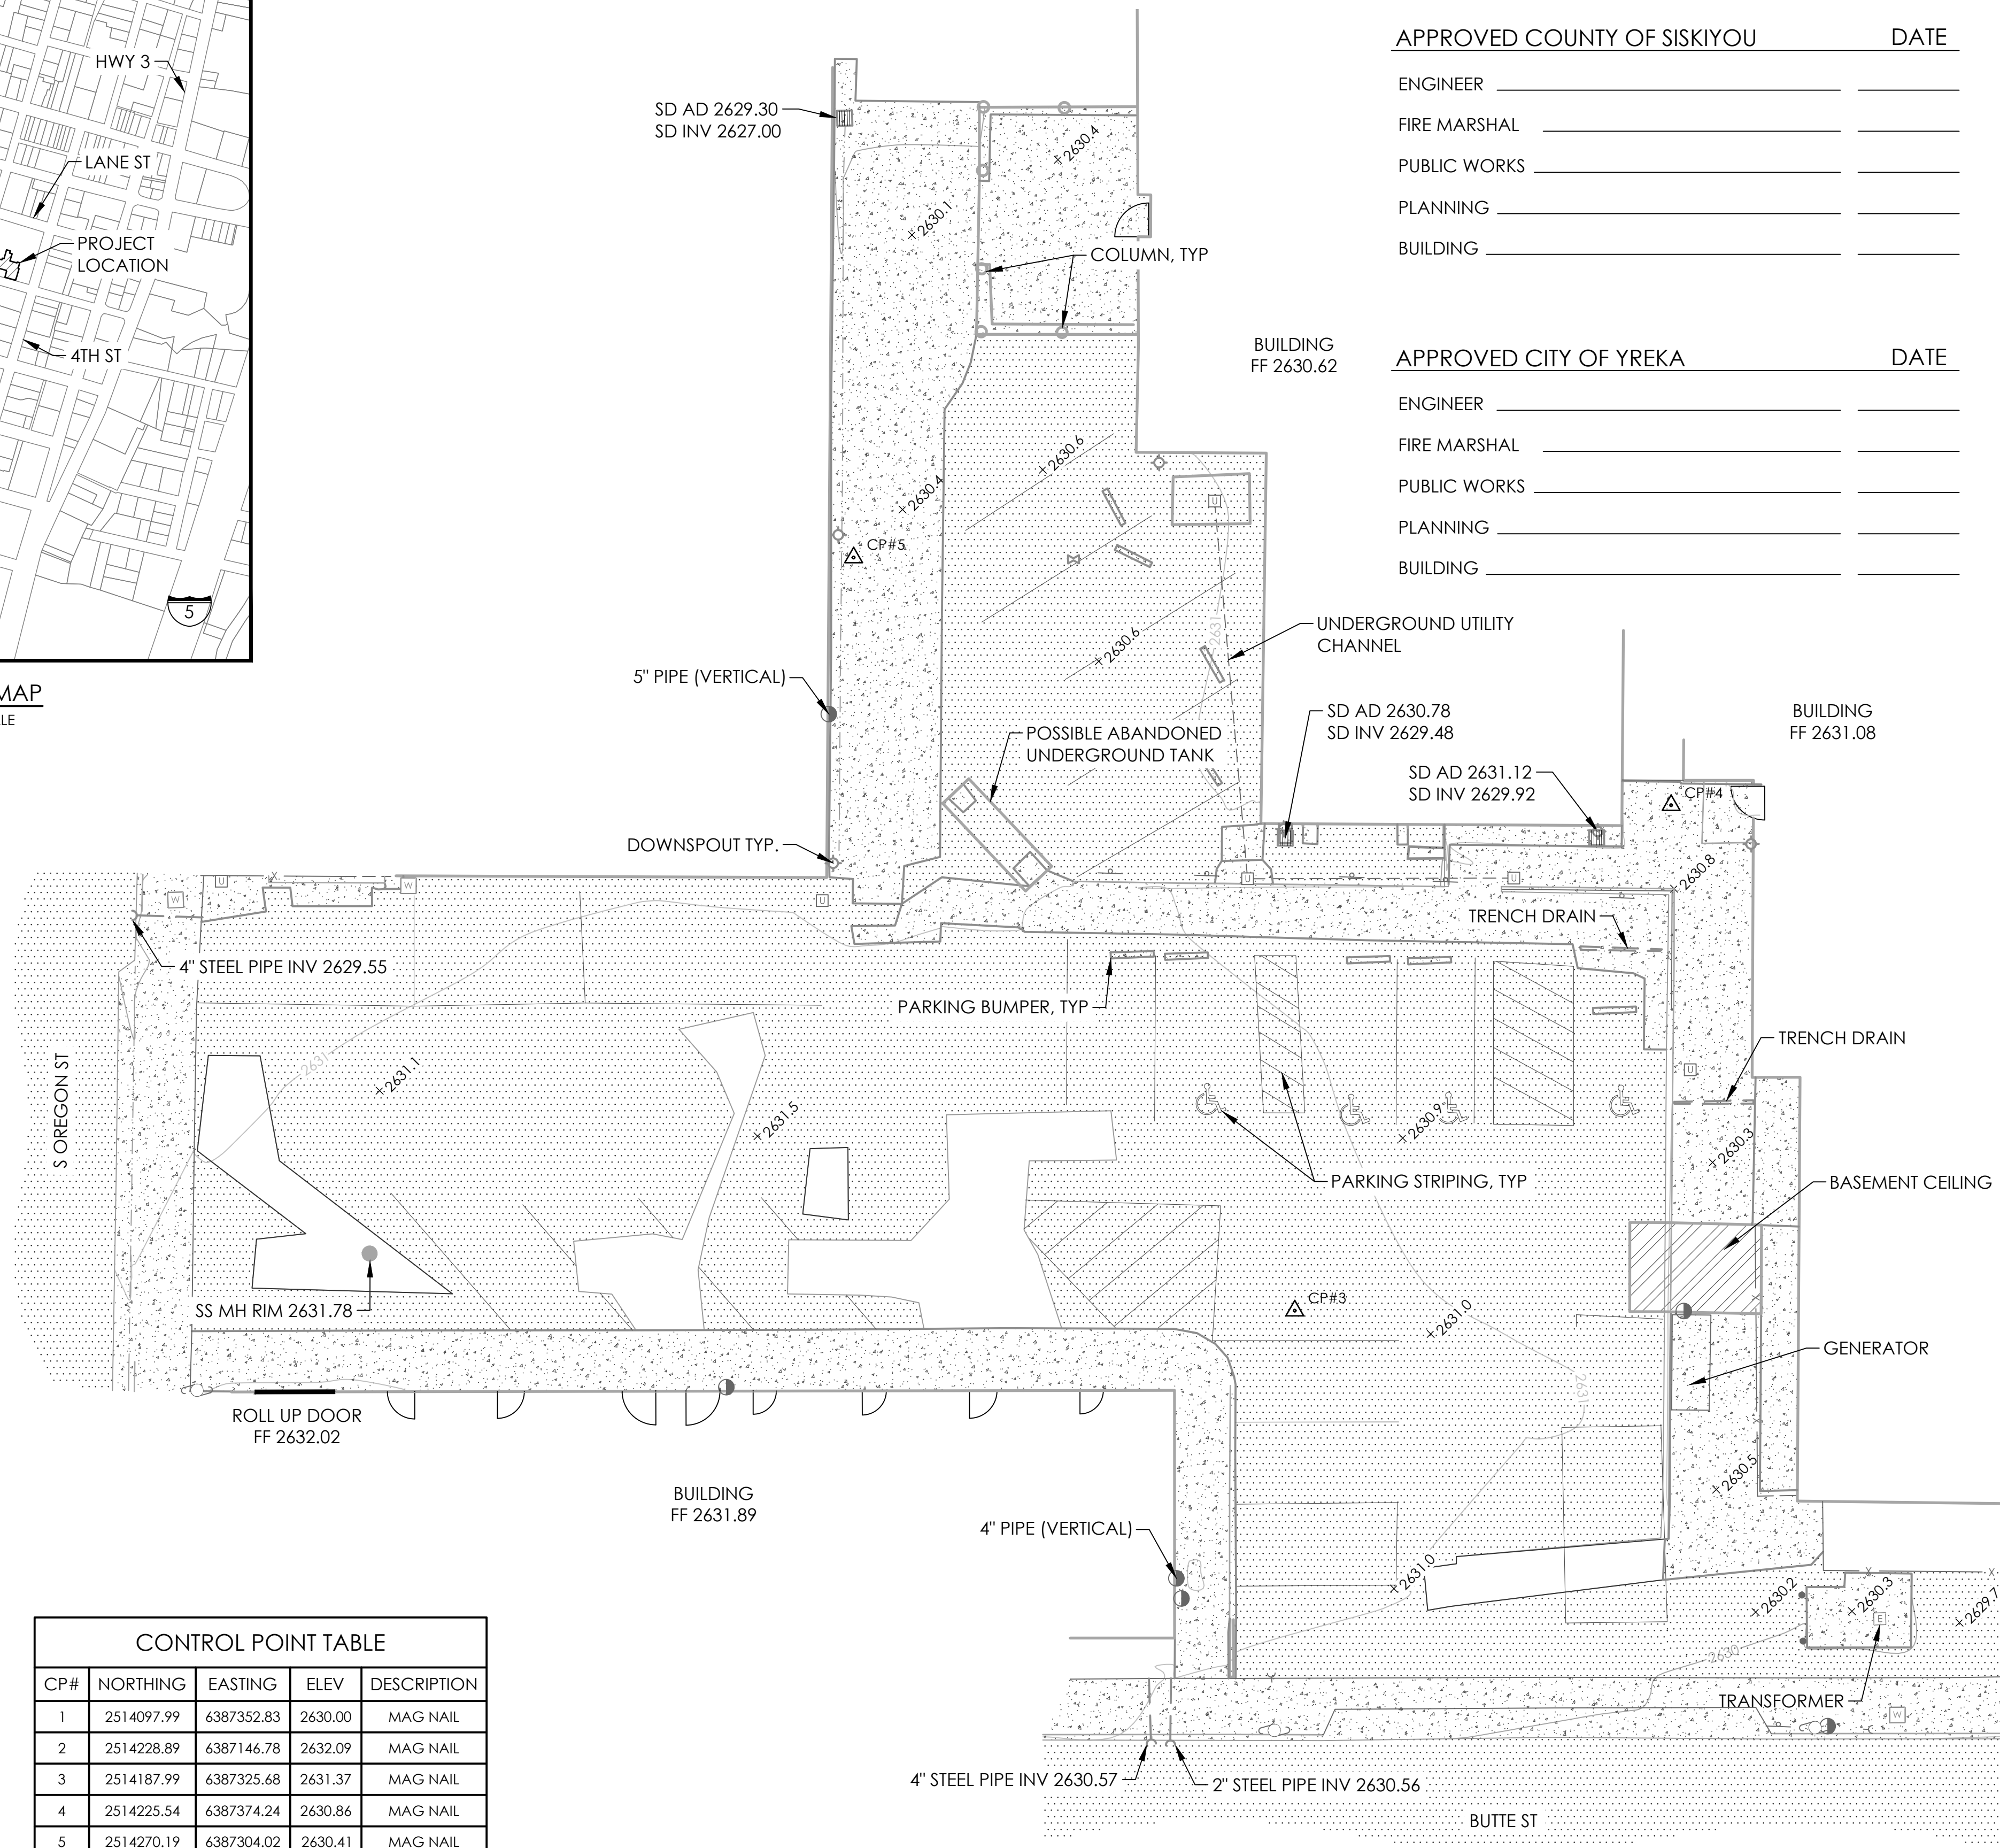

APPROVED COUNTY OF SISKIYOU _____ DATE _____
 ENGINEER _____
 FIRE MARSHAL _____
 PUBLIC WORKS _____
 PLANNING _____
 BUILDING _____

APPROVED CITY OF YREKA _____ DATE _____
 ENGINEER _____
 FIRE MARSHAL _____
 PUBLIC WORKS _____
 PLANNING _____
 BUILDING _____

- SYMBOL LEGEND**
- AREA DRAIN
 - BOLLARD
 - CONDUIT
 - △^{CP#} CONTROL POINT
 - ◇ DOWNSPOUT
 - > PIPE CULVERT/OUTLET
 - ELECTRICAL PANEL / BOX
 - > GUY ANCHOR
 - POLE- JOINT UTILITY
 - SANITARY SEWER MANHOLE
 - UNKNOWN UTILITY VAULT
 - WATER METER/BOX
 - ⊗ WATER VALVE

- LINE LEGEND**
- VERTICAL CURB
 - EP
 - CONC
 - FLOWLINE
 - FENCE

- ABBREVIATIONS**
- AD AREA DRAIN
 - CO CLEANOUT
 - CONC CONCRETE
 - CP CONTROL POINT
 - DS DOWNSPOUT
 - D/W DRIVEWAY
 - EL/ELEV ELEVATION
 - FF FINISH FLOOR
 - GR GRATE
 - INV INVERT
 - MH MANHOLE
 - SD STORM DRAIN
 - SS SANITARY SEWER
 - TYP TYPICAL
 - W WATER
 - WV WATER VALVE

- HATCH LEGEND**
- ▨ CONCRETE
 - ▩ PAVEMENT

PROJECT TEAM

OWNER (COUNTY OF SISKIYOU):
 AMANDA KIMBALL (DIRECTOR OF FACILITIES)
 EMAIL: AKimball2@co.siskiyou.ca.us
 PHONE: (530) 842-8800

ADS/STORMTECH CONTACT:
 NELSON TEJADA
 EMAIL: Nelson.Tejada@adspipe.com
 PHONE: (916) 990-2279

PROJECT DESIGN TEAM (PACE):

SHAWN WADE (PROJECT MANAGER)
 EMAIL: SWade@paceengineering.us
 PHONE: (530) 244-0202

RYAN TURNER (CIVIL ENGINEER)
 EMAIL: RTurner@paceengineering.us
 PHONE: (530) 244-0202


NICHOLAS PECK (ELECTRICAL ENGINEER)
 EMAIL: NPeck@paceengineering.us
 PHONE: (530) 244-0202

LIBERTY PUMP CONTACT:
 JON EMASIE
 EMAIL: Jon.Emasie@libertypumps.com
 PHONE: (800) 543-2550

- SURVEY NOTES**
- THIS SURVEY WAS CONDUCTED ON 5/2/2024.
 - COORDINATE SYSTEM: CALIFORNIA COORDINATE SYSTEM OF 1983 (CCS83), ZONE 1, (EPOCH 2017.5).
 - VERTICAL DATUM: NORTH AMERICAN VERTICAL DATUM OF 1988 (NAVD88), (GEOID 18)
 - CONTOUR INTERVAL: 1 FOOT.
 - UNITS OF MEASUREMENT SHOWN HEREON ARE IN TERMS OF THE U.S. SURVEY FOOT AND DECIMALS THEREOF.
 - UTILITIES/FEATURES SHOWN HEREON ARE BASED UPON ABOVE-GROUND, OBSERVED EVIDENCE ONLY.

SHEET INDEX		
PAGE	SHEET	TITLE
1	C1.0	TITLE SHEET AND TOPOGRAPHIC MAP
2	C1.1	DEMO PLAN
3	C2.0	PHASE 1 SITE PLAN
4	C2.1	PHASE 2 SITE PLAN
5	C3.0	PHASE 1 GRADING PLAN
6	C3.1	PHASE 2 GRADING PLAN
7	C4.0	EROSION SEDIMENT CONTROL PLAN
8	C5.0	POST CONSTRUCTION STANDARDS PLAN
9	C6.0	STANDARD DETAILS
10	C6.1	STANDARD DETAILS
11	C6.2	ADA AND EROSION CONTROL DETAILS
12	C6.3	INFILTRATION GALLERY DETAILS
13	C6.4	INFILTRATION GALLERY DETAILS
14	C6.5	SUMP PUMP DETAILS
15	E0.0	ELECTRICAL SPECIFICATIONS
16	E0.1	ONE-LINE DIAGRAM AND ELECTRICAL PLANS
17	E1.0	TITLE 24 ELECTRICAL COMPLIANCE DOCUMENTS

CP#	NORTHING	EASTING	ELEV	DESCRIPTION
1	2514097.99	6387352.83	2630.00	MAG NAIL
2	2514228.89	6387146.78	2632.09	MAG NAIL
3	2514187.99	6387325.68	2631.37	MAG NAIL
4	2514225.54	6387374.24	2630.86	MAG NAIL
5	2514270.19	6387304.02	2630.41	MAG NAIL

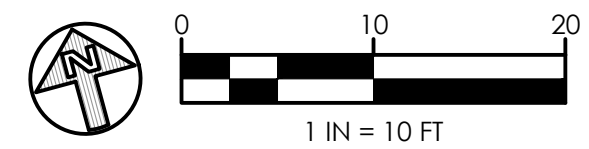

PERMIT SET

BAR IS ONE INCH ON ORIGINAL DRAWING
 0" 1"
 IF NOT ONE INCH ON THIS SHEET, ADJUST SCALES ACCORDINGLY.

NO	DATE	DESCRIPTION

PACE ENGINEERING

DES: RT CKD: TJSWg JOB NO. 0470.22
 DRN: RT DATE: 9/10/24




SISKIYOU COUNTY GOVERNMENT CENTER
 PARKING LOT IMPROVEMENTS

TITLE SHEET AND TOPOGRAPHIC MAP

SHEET
C1.0
 PG 1 OF 17




Plot Date: September 10, 2024 - 9:03 am, Login Name: rturner
 File Name: M:\land projects\047022_government_center_parking\01_CAD\05_C01\Topo\Avg_Layout_Topo

DEMOLITION LEGEND

- TBA TO BE ABANDONED
- TBR TO BE REMOVED
-  DEMOLITION AREA
(CONC, SIDEWALK, PAVEMENT)

DEMOLITION NOTES:


1. CALL USA (811 OR 1-800-227-2600) 48 HOURS PRIOR TO ANY DEMOLITION ACTIVITIES TO LOCATE UTILITIES.
2. CONTRACTOR SHALL COORDINATE AND ARRANGE FOR THE DISCONNECTION OF ALL UTILITIES BEING MODIFIED OR DEMOLISHED WITH THE OWNER AND UTILITY COMPANIES. THE CONTRACTOR SHALL PROPERLY CAP ALL UNUSED OR ABANDONED UTILITIES.
3. ALL DEMOLISHED MATERIALS NOT CALLED OUT IN THE DRAWINGS TO BE RETURNED TO THE OWNER ARE TO BE PROPERLY DISPOSED OF OFF-SITE.
4. THE CONTRACTOR SHALL MAINTAIN EXISTING STORM DRAINAGE SYSTEMS TO FUNCTION THROUGHOUT THE CONSTRUCTION PERIOD WITH APPROPRIATE EROSION AND SEDIMENT CONTROL DEVICES IN PLACE AS SHOWN ON SHEET C4.0.
5. IT IS THE CONTRACTORS RESPONSIBILITY TO REMOVE AND LEGALLY DISPOSE OF ANY EXCESS FILL MATERIAL AND WASTE GENERATED DURING GRADING AND CONSTRUCTION OPERATIONS.
6. THE CONTRACTOR SHALL ASSUME RESPONSIBILITY FOR THE PROTECTION OF ALL PROPERTY CORNER MONUMENTS, AND SHALL HAVE, AT HIS EXPENSE, ALL CORNER MONUMENTS REPLACED WHICH ARE DISTURBED BY CONSTRUCTION ACTIVITIES.

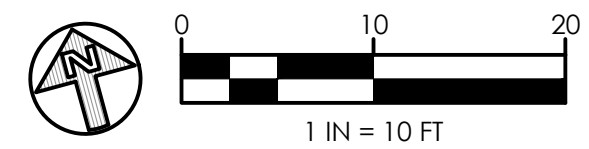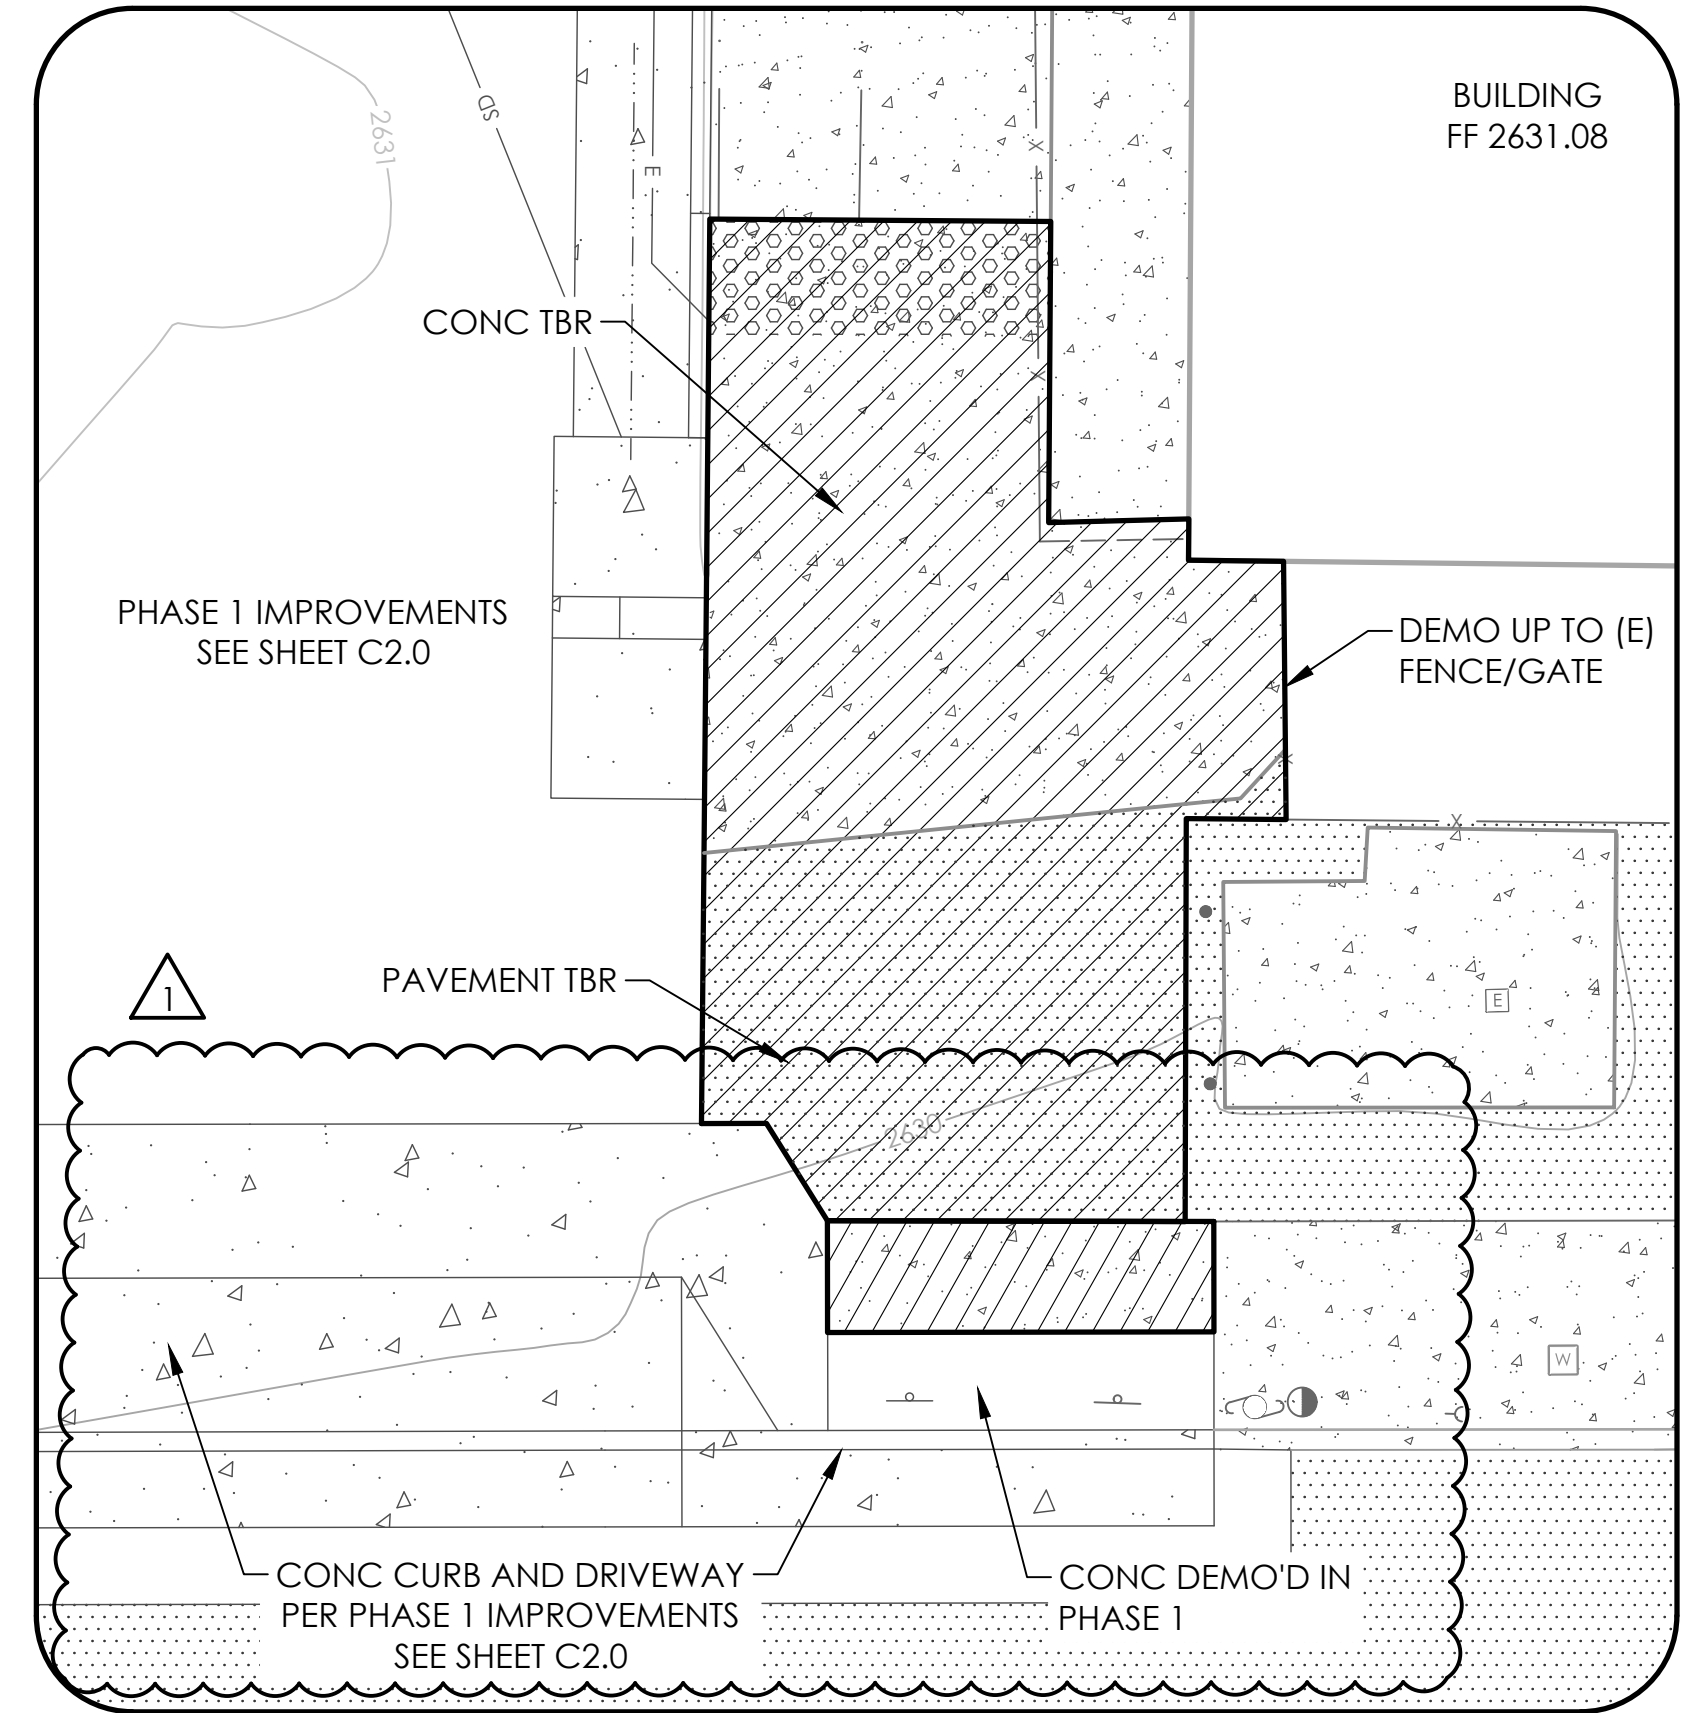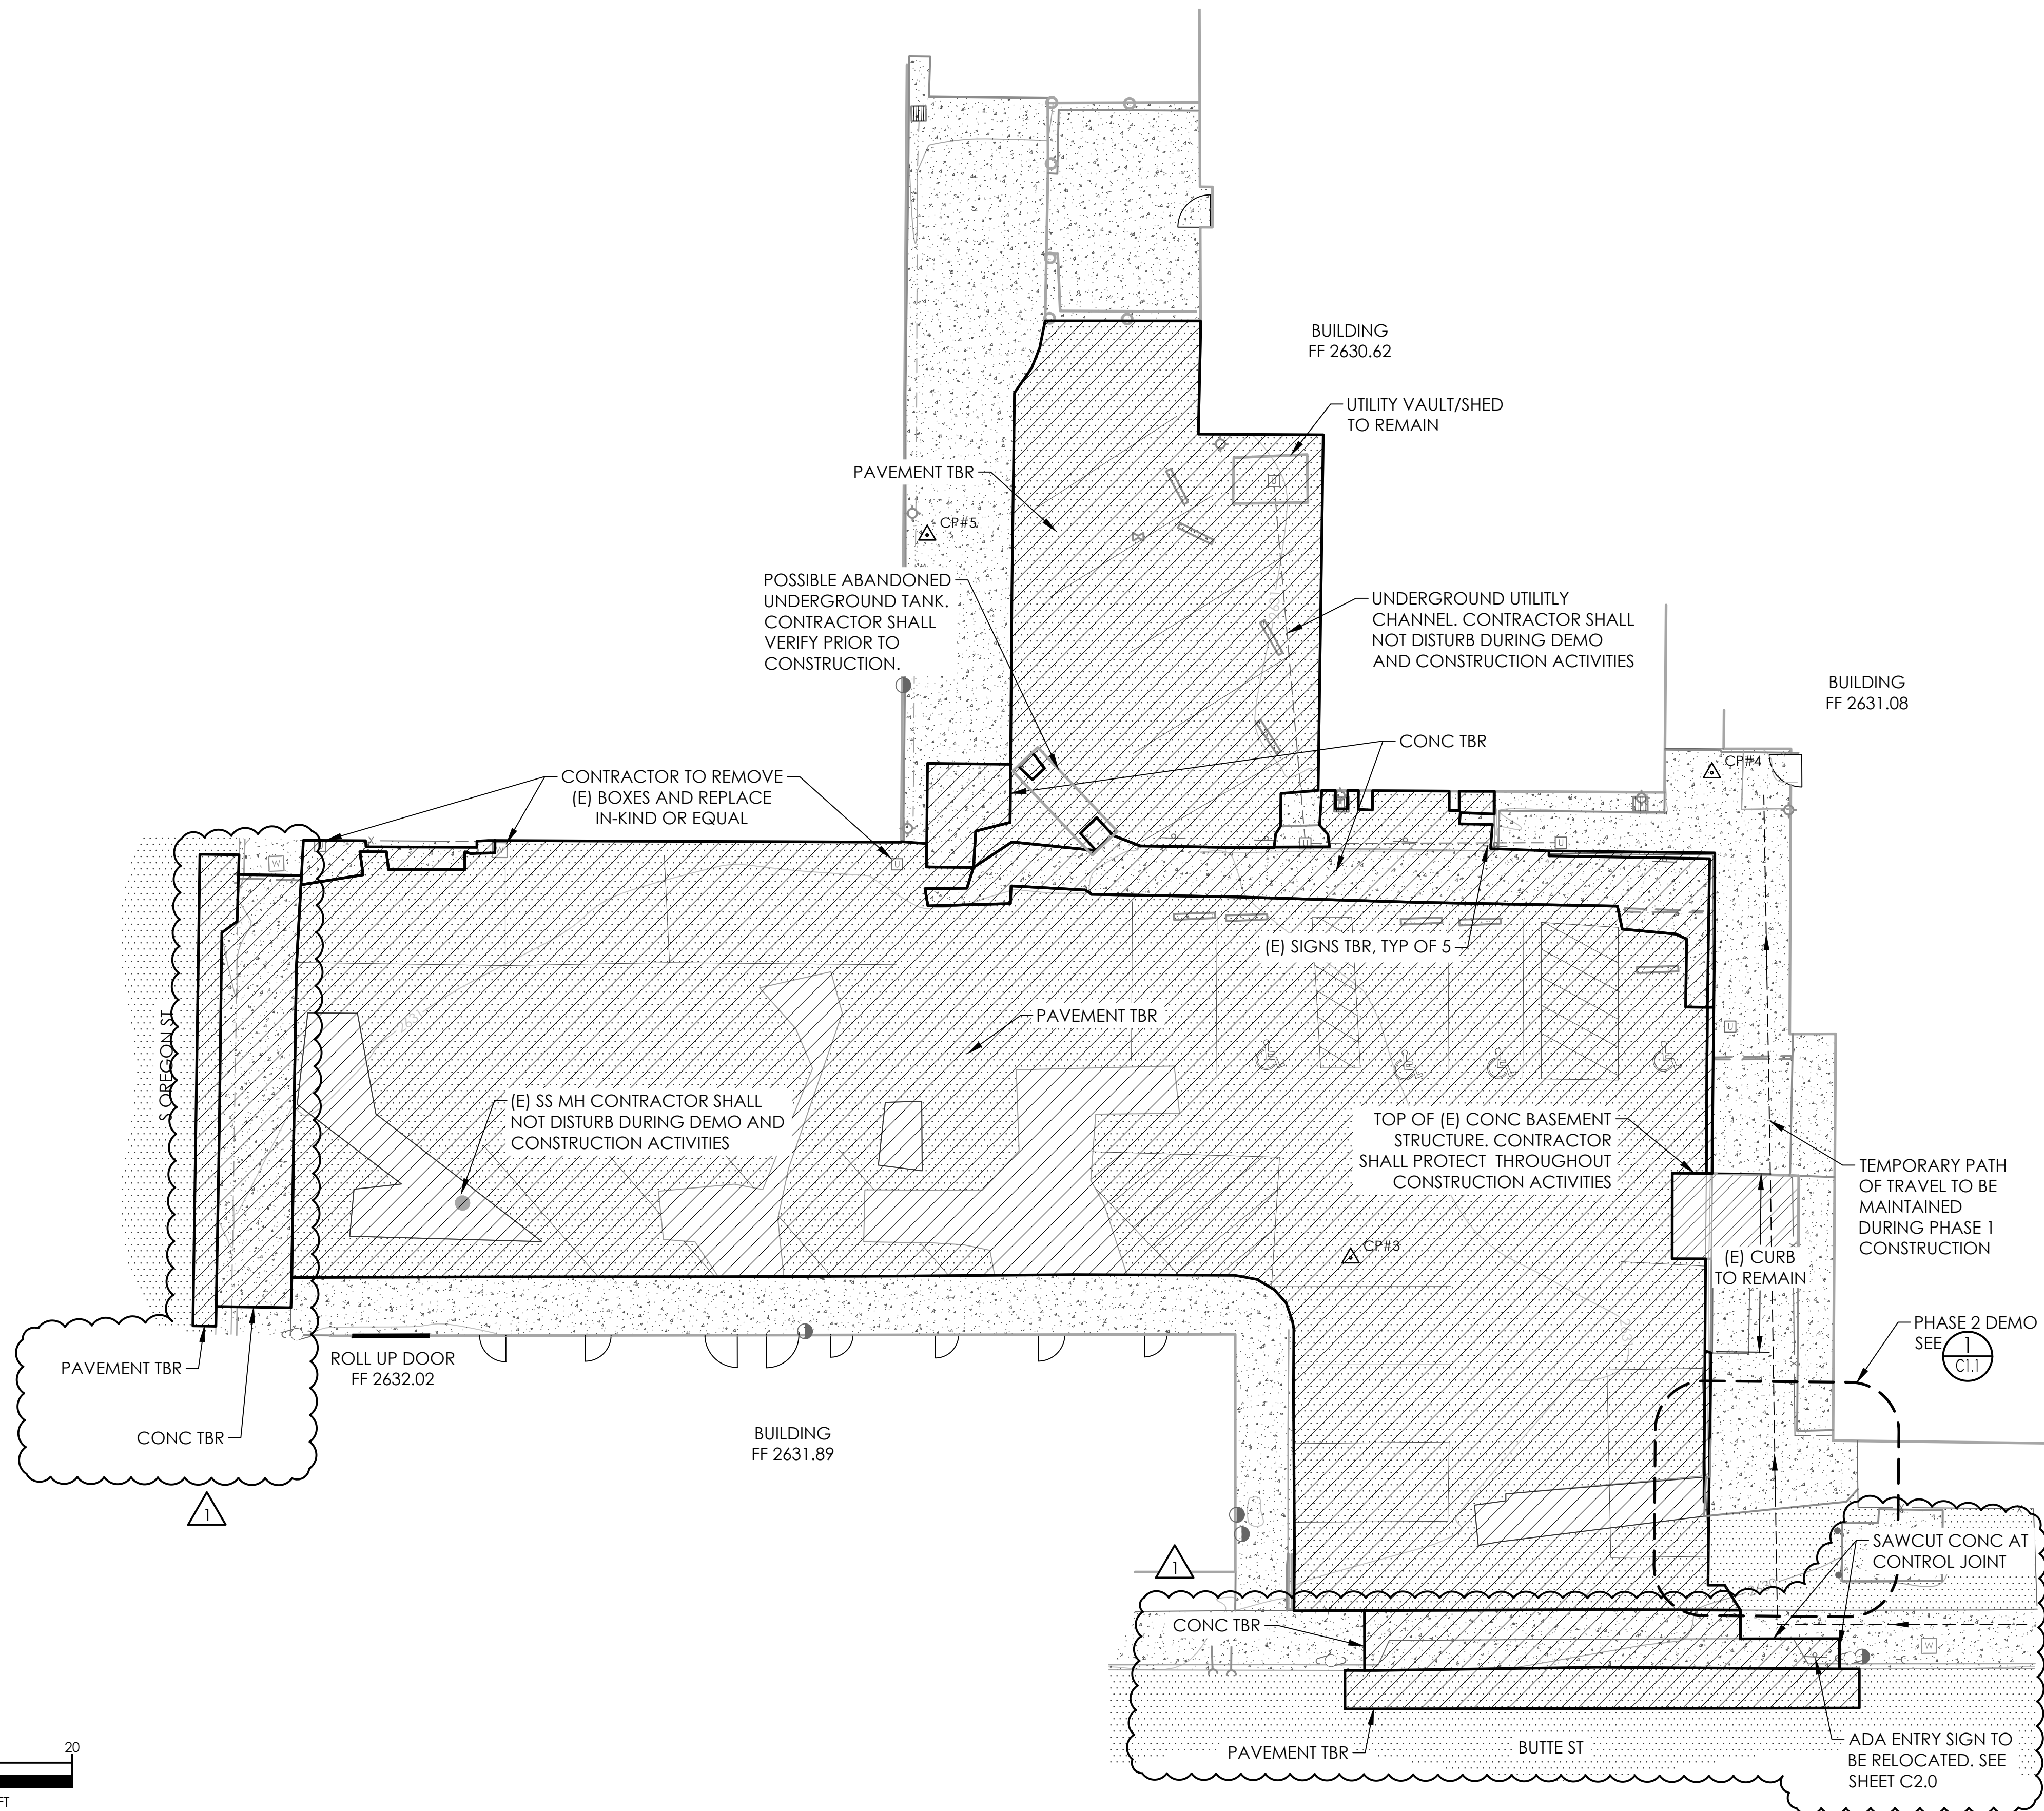

PERMIT SET

BAR IS ONE INCH ON ORIGINAL DRAWING
0" 1"
IF NOT ONE INCH ON THIS SHEET, ADJUST SCALES ACCORDINGLY.

REVISIONS		
NO	DATE	DESCRIPTION
1	9-9-24	DRIVEWAY ENTRANCE IMPROVEMENTS

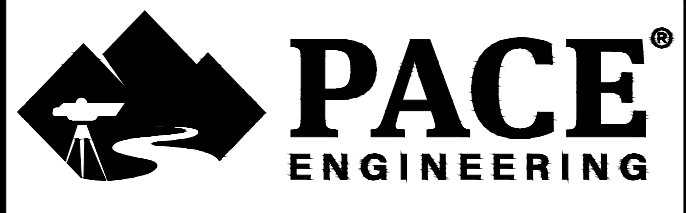

DES RT CKD TJ/SWg JOB NO.
DRN RT DATE 9/10/24 0470.22



SISKIYOU COUNTY GOVERNMENT CENTER
PARKING LOT IMPROVEMENTS

DEMO PLAN

SHEET

C1.1

PG 2 OF 17

Plot Date: September 10, 2024 - 9:03 am, Login Name: rturner, File Name: M:\land projects\047022_government_center_parking\01_CAD\05_C01\Topo\wg_Layer1_Demo

SYMBOL LEGEND

- AREA DRAIN
- BOLLARD
- CONDUIT
- △^{CP#} CONTROL POINT
- ◇ DOWNSPOUT
- › PIPE CULVERT/OUTLET
- ELECTRICAL PANEL / BOX
- › GUY ANCHOR
- POLE- JOINT UTILITY
- SANITARY SEWER MANHOLE
- ⊥ SIGN
- UNKNOWN UTILITY VAULT
- WATER METER/BOX
- ⊥ WATER VALVE

LINE LEGEND

- ===== VERTICAL CURB
- (E) EP
- (N) EP
- (E) CONC
- (N) CONC
- FLOWLINE

ABBREVIATIONS

- AD AREA DRAIN
- CO CLEANOUT
- CONC CONCRETE
- CP CONTROL POINT
- DS DOWNSPOUT
- D/W DRIVEWAY
- (E) EXISTING
- EL/ELEV ELEVATION
- ELEC ELECTRICAL
- FF FINISH FLOOR
- FG FINISH GRADE
- GR GRATE
- INV INVERT
- MH MANHOLE
- (N) NEW
- SD STORM DRAIN
- SS SANITARY SEWER
- TYP TYPICAL
- W WATER
- WV WATER VALVE



HATCH LEGEND

- (E) CONCRETE
- (N) CONCRETE
- (E) PAVEMENT
- (N) PAVEMENT (3" HMA OVER 12" AB)
- INFILTRATION GALLERY, SEE C5.0
- TRUNCATED DOMES, SEE NOTE 8

NOTES

1. THE CONSTRUCTION AND INSTALLATION OF IMPROVEMENTS SHALL CONFORM TO THESE PLANS, THE CITY OF YREKA CONSTRUCTION STANDARDS, STATE OF CALIFORNIA - DEPARTMENT OF TRANSPORTATION 2022 STANDARD PLANS AND SPECIFICATIONS (RSS), AND THE STANDARD SPECIFICATIONS FOR PUBLIC WORKS CONSTRUCTION (GREEN BOOK).
2. THE CONTRACTOR SHALL OBTAIN AN ENCROACHMENT PERMIT PRIOR TO ANY WORK IN THE STREET RIGHT-OF-WAY.
3. CALL USA (811) TO LOCATE ALL UTILITIES 48 HOURS PRIOR TO ANY CONSTRUCTION.
4. ANY CHANGES IN THESE PLANS ARE TO RECEIVE PRIOR APPROVAL OF THE OWNER AND PACE ENGINEERING, INC.
5. POT HOLE AND VERIFY LOCATIONS OF ALL PIPE AND UTILITY CROSSINGS PRIOR TO CONSTRUCTION.
6. PARKING BUMPERS SHALL BE 4-FOOT LONG PRE-CAST CONCRETE AS PER COOK CONCRETE PRODUCTS, ITEM PB 4 OR EQUAL. EACH BUMPER SHALL BE ANCHORED WITH TWO PIECES OF 1/2-INCH REBAR, 24" LONG.
7. ALL PAVEMENT STRIPES AND MARKINGS SHALL BE WATERBASED PER CALTRANS RSS SECTION 84-2.02C.
8. TRUNCATED DOMES SHALL HAVE A MINIMUM WIDTH OF 36", UNLESS NOTED OTHERWISE ON SHEET C6.2 AND CONFORM TO CALIFORNIA BUILDING CODE (CBC) SECTION 11B-705 IN THE AREAS SHOWN ON THE DRAWINGS.

PARKING SPACE ANALYSIS		
TYPE	EXISTING	PROPOSED
REGULAR SPACES	12	14
ADA ACCESSIBLE SPACES	4	3
COMPACT SPACES	4	2
TOTAL SPACES	20	19

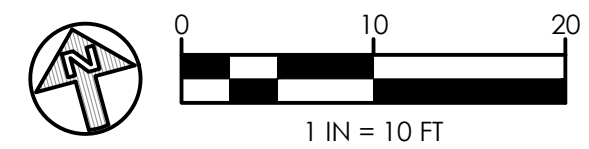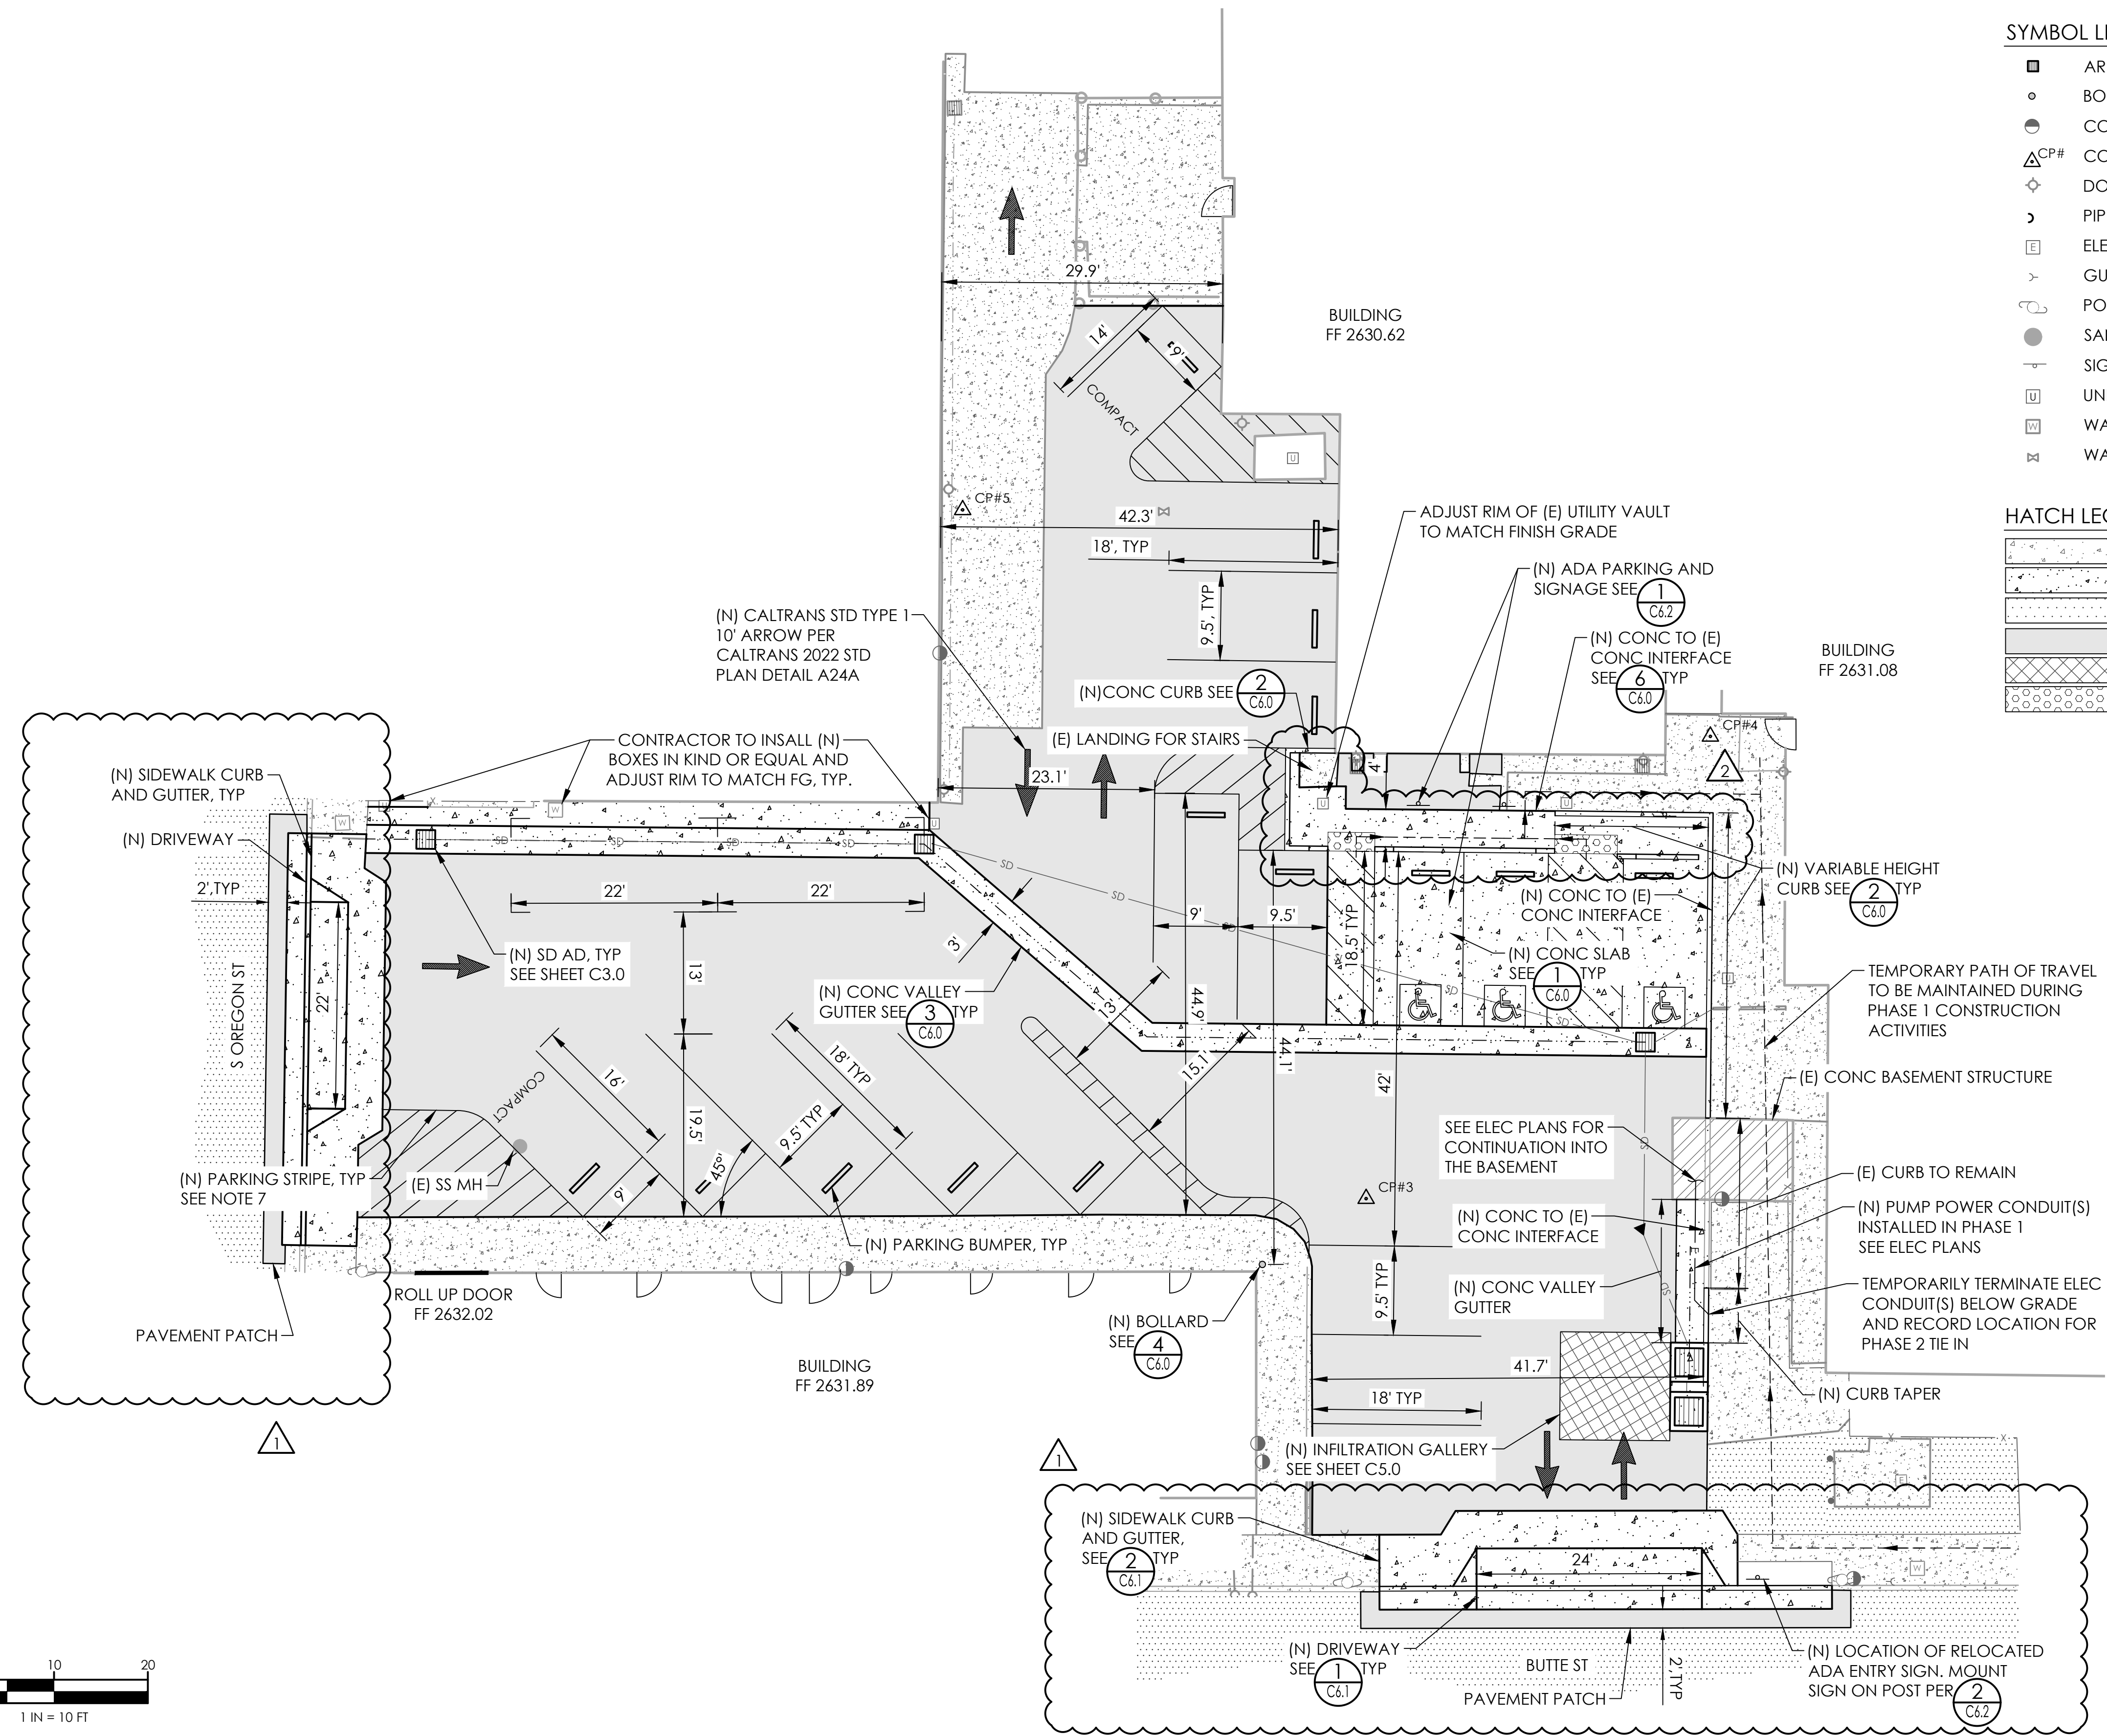

PERMIT SET

BAR IS ONE INCH ON ORIGINAL DRAWING
 0" 1"
 IF NOT ONE INCH ON THIS SHEET, ADJUST SCALES ACCORDINGLY.

REVISIONS		
NO	DATE	DESCRIPTION
1	9-9-24	DRIVEWAY ENTERANCE IMPROVEMENTS
2	9-18-24	PLAN CHECK REVISIONS

PACE ENGINEERING

DES: RT CKD: TJSWg JOB NO.
 DRN: RT DATE: 9/18/24 0470.22

SIGNED 9/18/24

SISKIYOU COUNTY GOVERNMENT CENTER
 PARKING LOT IMPROVEMENTS


PHASE 1 SITE PLAN

SHEET

C2.0

PG 3 OF 17

Plot Date: September 18, 2024, 2:02 pm, Login Name: rturner
 File Name: M:\land projects\047022_government_center_ada_parking\01_CAD\05_CD\Sheetwg_Layout_P1_Site

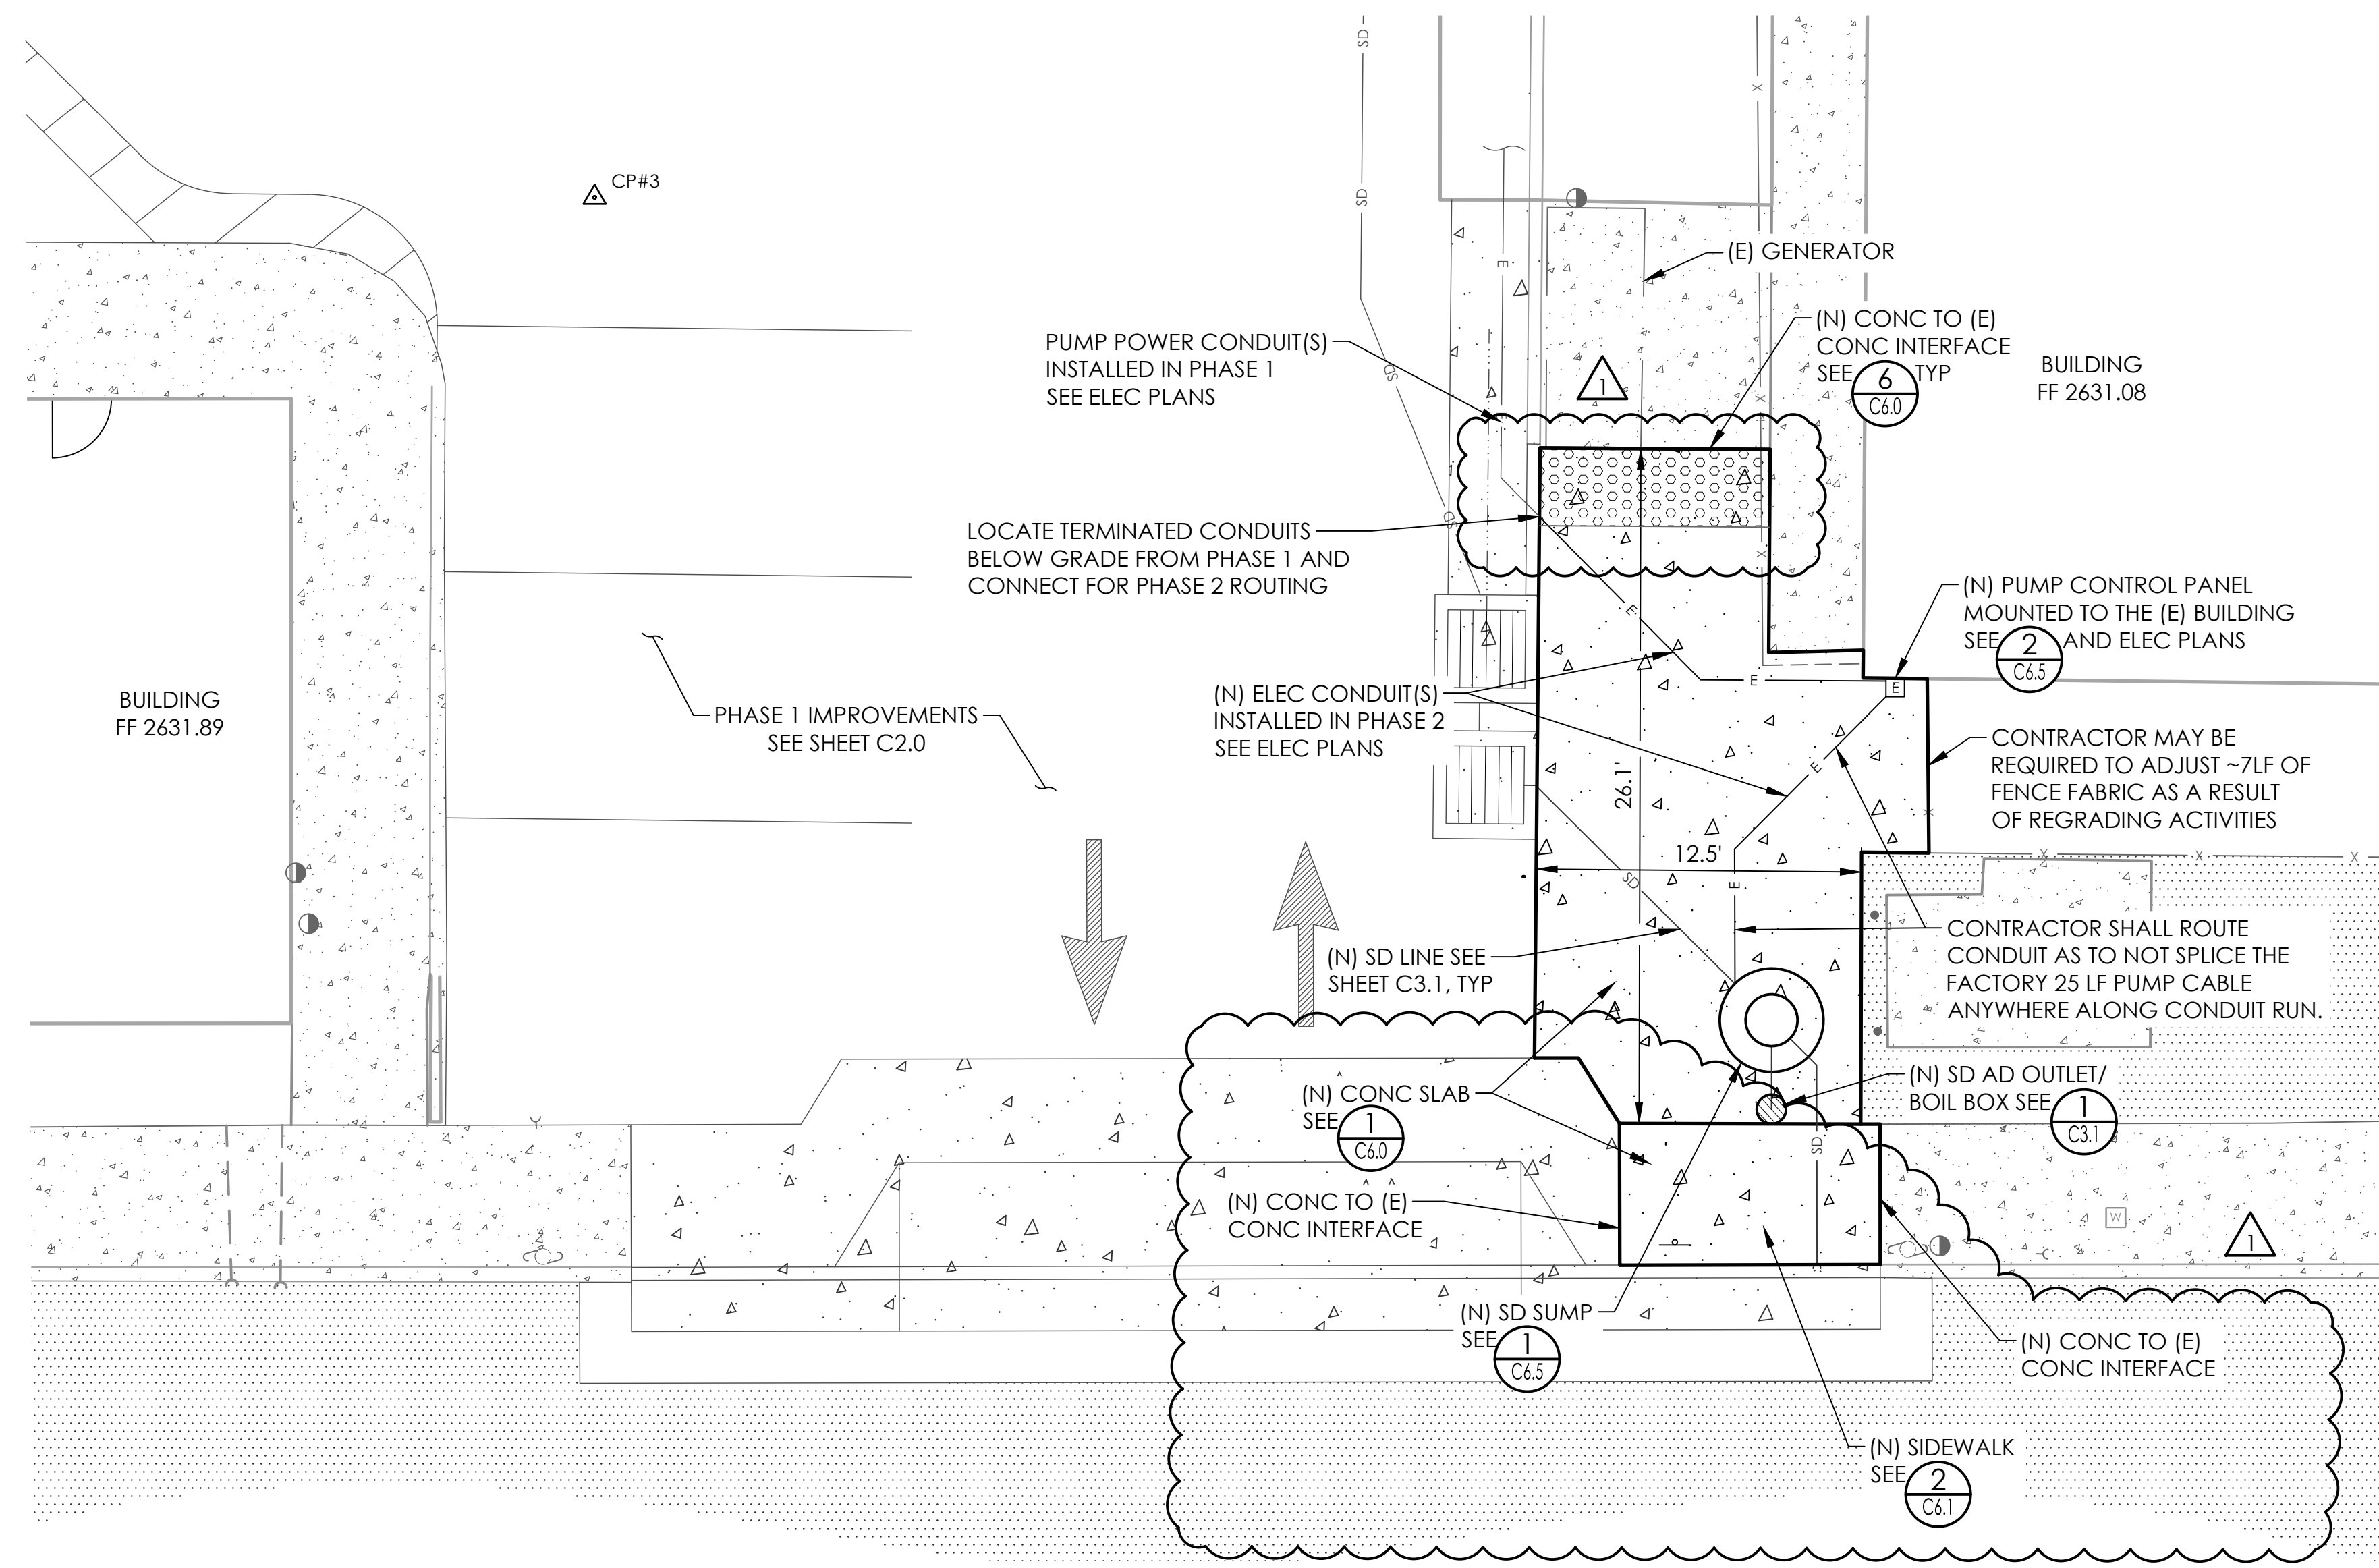

SYMBOL LEGEND

- AREA DRAIN
- BOLLARD
- CONDUIT
- △^{CP#} CONTROL POINT
- ◇ DOWNSPOUT
- ⋄ PIPE CULVERT/OUTLET
- ELECTRICAL PANEL / BOX
- ⋈ GUY ANCHOR
- ⊕ POLE- JOINT UTILITY
- SANITARY SEWER MANHOLE
- ⊥ SIGN
- UNKNOWN UTILITY VAULT
- ⊞ WATER METER/BOX
- ⊞ WATER VALVE

LINE LEGEND


- ===== VERTICAL CURB
- (E) EP
- (N) EP
- (E) CONC
- (N) CONC
- FLOWLINE
- E (N) ELECTRICAL LINE
- SD (N) STORM DRAIN LINE

HATCH LEGEND

- [Pattern] (E) CONCRETE
- [Pattern] (N) CONCRETE
- [Pattern] (E) PAVEMENT
- [Pattern] TRUNCATED DOMES

ABBREVIATIONS

- AD AREA DRAIN
- CO CLEANOUT
- CONC CONCRETE
- CP CONTROL POINT
- DS DOWNSPOUT
- D/W DRIVEWAY
- (E) EXISTING
- EL/ELEV ELEVATION
- ELEC ELECTRICAL
- FF FINISH FLOOR
- FG FINISH GRADE
- GR GRATE
- INV INVERT
- LF LINEAL FEET
- MH MANHOLE
- (N) NEW
- SD STORM DRAIN
- SS SANITARY SEWER
- TYP TYPICAL
- W WATER
- WV WATER VALVE

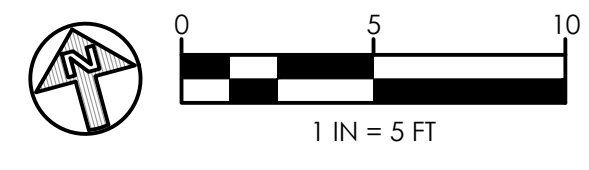

PERMIT SET

BAR IS ONE INCH ON ORIGINAL DRAWING
 0" ————— 1"
 IF NOT ONE INCH ON THIS SHEET, ADJUST SCALES ACCORDINGLY.

REVISIONS		
NO	DATE	DESCRIPTION
1	9-9-24	DRIVEWAY ENTRANCE IMPROVEMENTS

PACE ENGINEERING


DES: RT CKD: TJSWg JOB NO. DRN: RT DATE: 9/10/24 0470.22




SISKIYOU COUNTY GOVERNMENT CENTER
 PARKING LOT IMPROVEMENTS
 PHASE 2 SITE PLAN

SHEET
C2.1
 PG 4 OF 17

Plot Date: September 10, 2024 - 9:04 am, Login Name: rturner
 File Name: M:\land projects\047022_government_center_ada_parking\01_CAD\05_CD\Staging_Layout_P2_Site

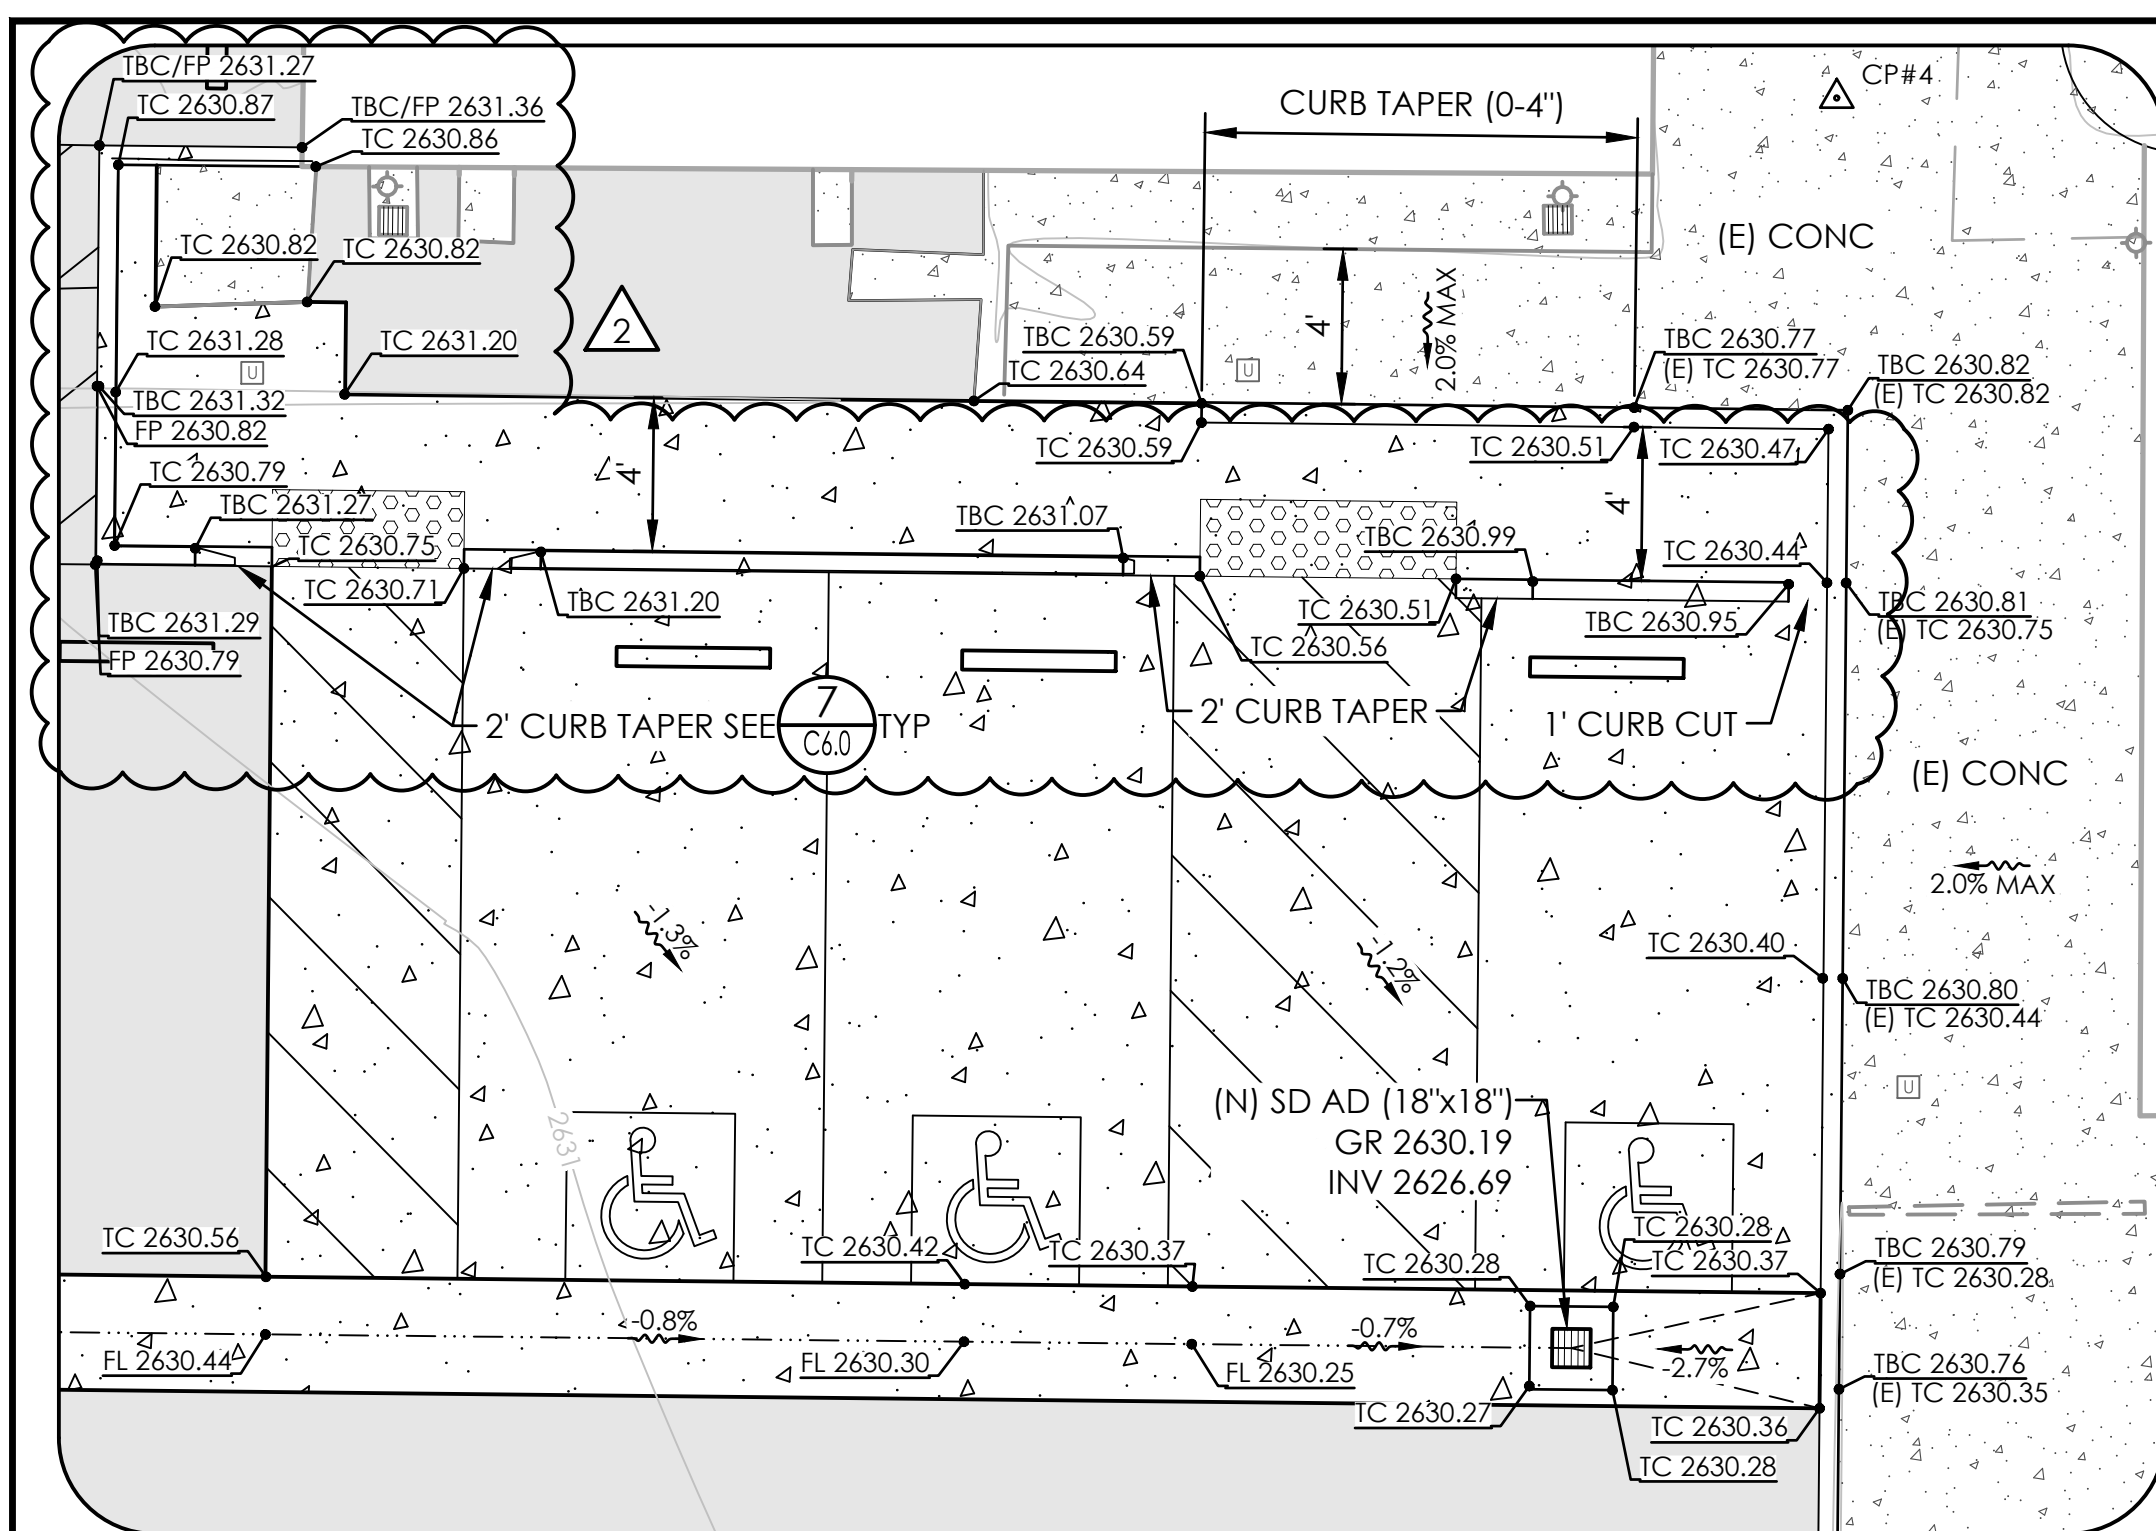

ENLARGED GRADING DETAIL 1
1" = 5'

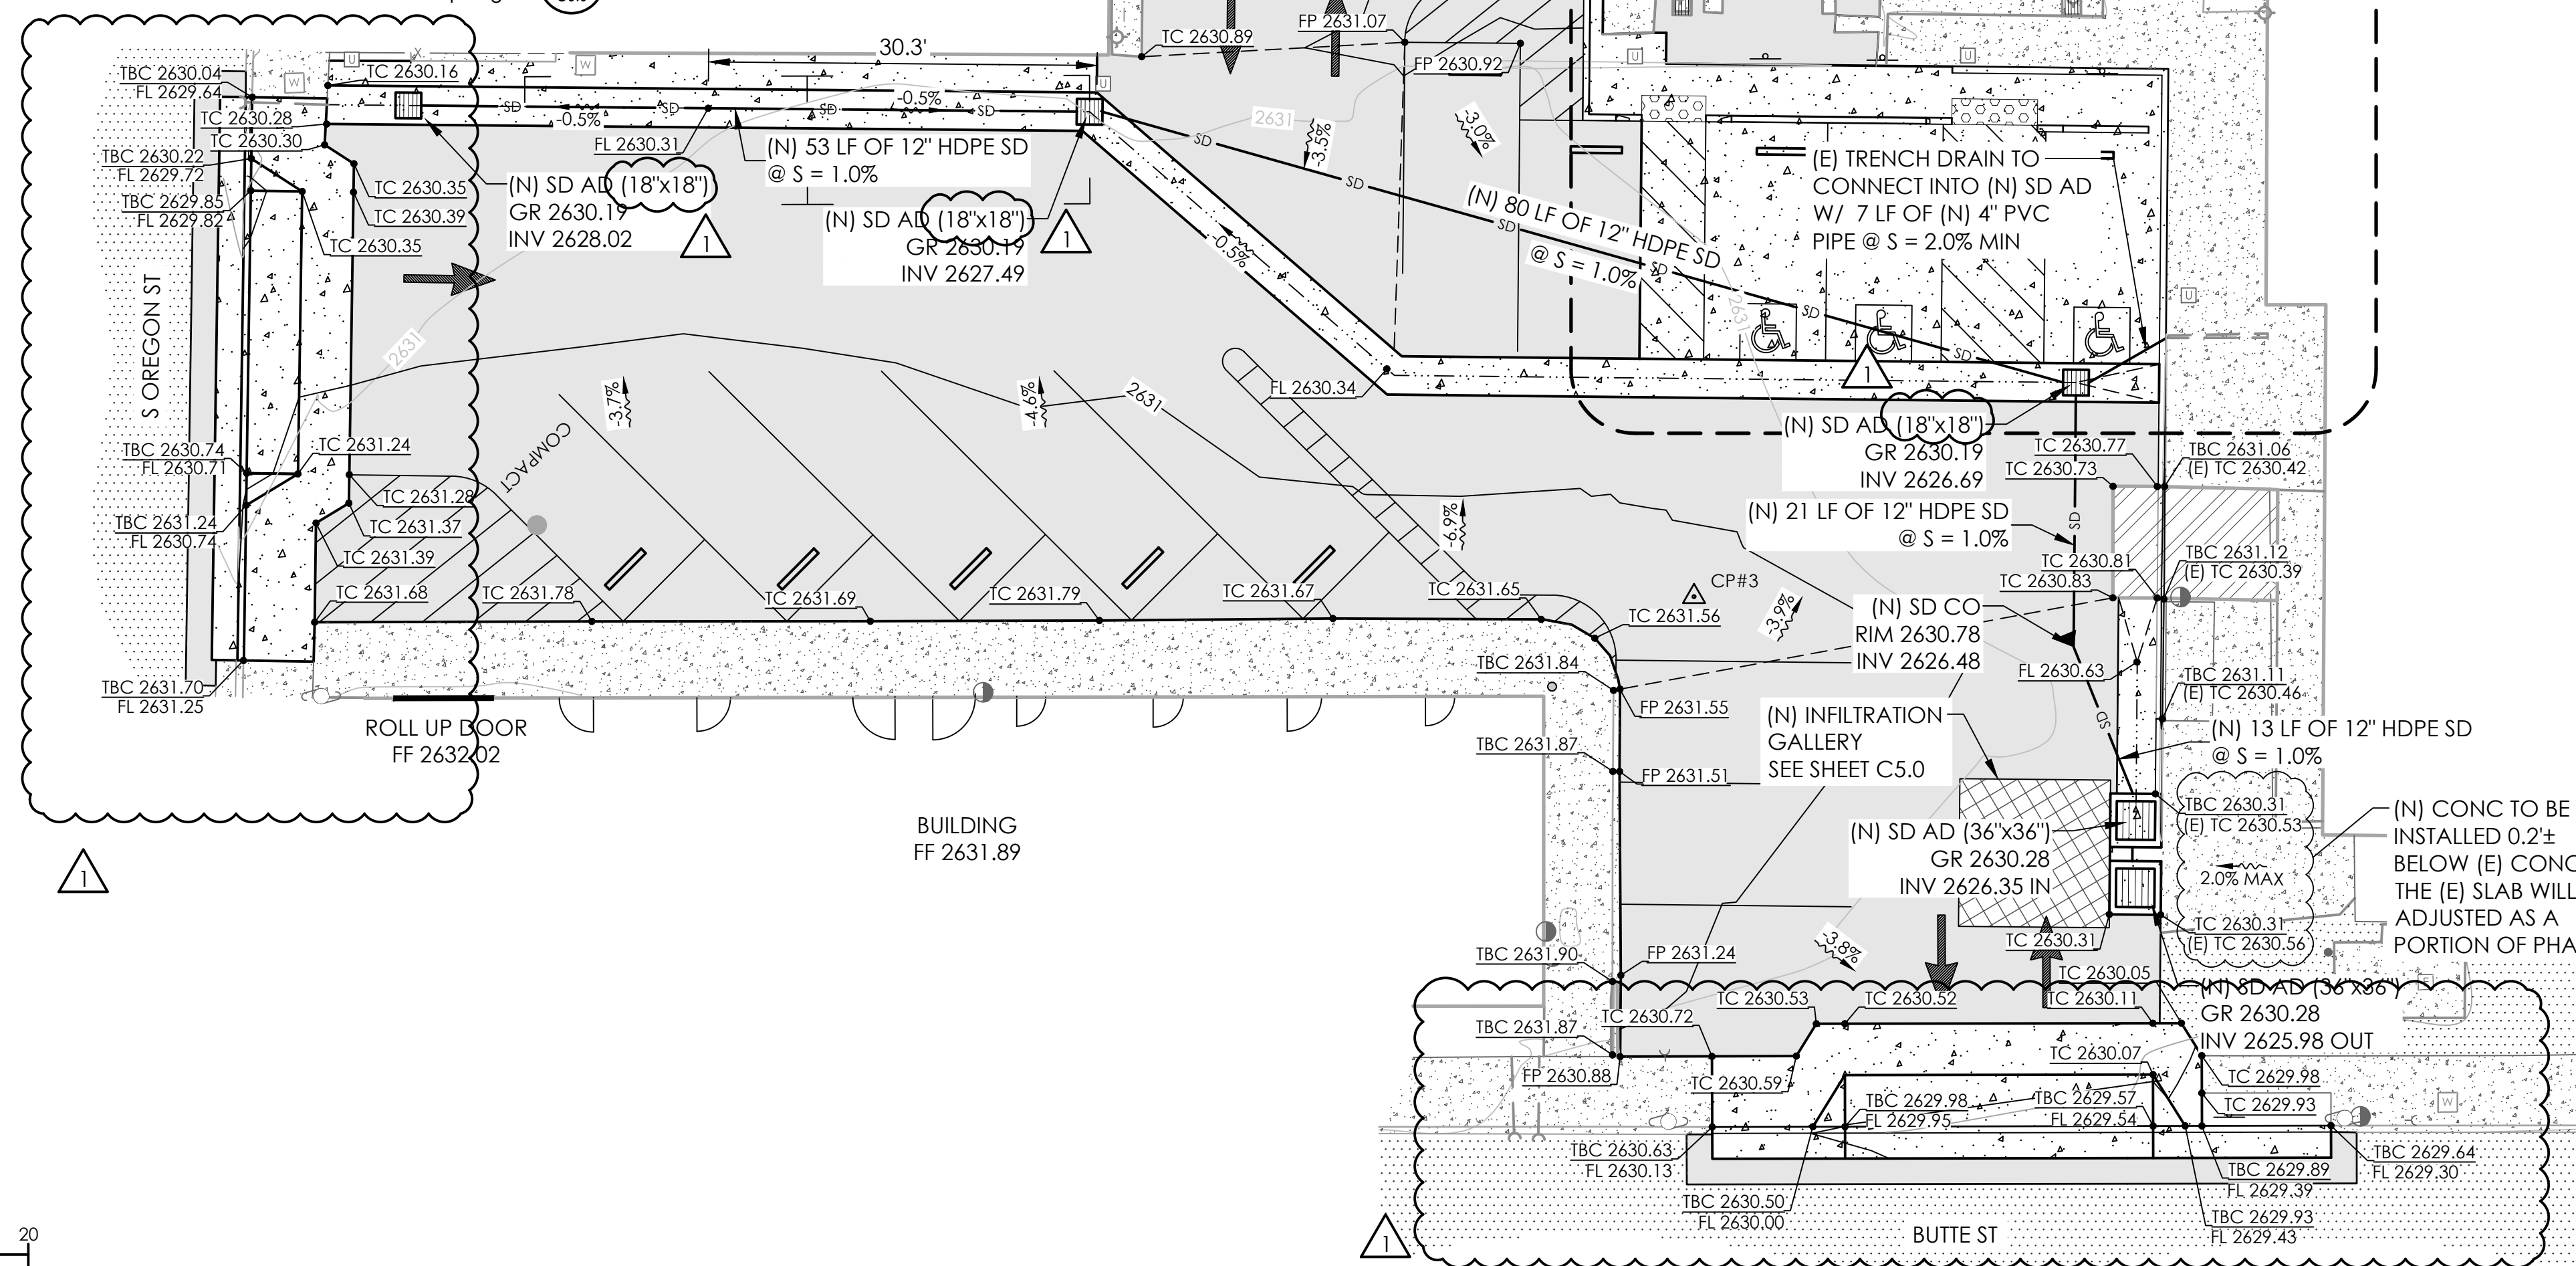

SYMBOL LEGEND

- AREA DRAIN
- BOLLARD
- CONDUIT
- △ CP# CONTROL POINT
- ◇ DOWNSPOUT
- ⤵ PIPE CULVERT/OUTLET
- ⊠ ELECTRICAL PANEL / BOX
- ⋈ GUY ANCHOR
- ⊕ POLE- JOINT UTILITY
- SANITARY SEWER MANHOLE
- ⊖ SIGN
- ⊠ UNKNOWN UTILITY VAULT
- ⊠ WATER METER/BOX
- ⊠ WATER VALVE

LINE LEGEND

- ===== VERTICAL CURB
- (E) EP
- (N) EP
- (E) CONC
- (N) CONC
- FLOWLINE
- SD (N) STORM DRAIN LINE

HATCH LEGEND

- [Hatch] (E) CONCRETE
- [Hatch] (N) CONCRETE
- [Hatch] (E) PAVEMENT
- [Hatch] (N) PAVEMENT, SEE SHEET C2.0
- [Hatch] INFILTRATION GALLERY, SEE C5.0

ABBREVIATIONS

- AB AGGREGATE BASE
- AD AREA DRAIN
- CO CLEANOUT
- CONC CONCRETE
- CP CONTROL POINT
- DS DOWNSPOUT
- (E) EXISTING
- ELB ELBOW
- EL/ELEV ELEVATION
- ELEC ELECTRICAL
- FF FINISH FLOOR
- FP FINISH PAVEMENT
- FL FLOWLINE
- FG FINISH GRADE
- GR GRATE
- HMA HOT MIX ASPHALT
- INV INVERT
- LF LINEAL FEET
- MH MANHOLE
- (N) NEW
- S SLOPE
- SD STORM DRAIN
- SS SANITARY SEWER
- TBC TOP BACK OF CURB
- TC TOP OF CONCRETE
- TYP TYPICAL
- W/ WITH
- W WATER
- WV WATER VALVE

NOTES


1. SEE SHEET C2.0 FOR DIMENSIONS NOT SHOWN.
2. ALL SITE CONCRETE SHALL BE CLASS 520-C-2500 AND CONFORM TO THE "STANDARD SPECIFICATIONS FOR PUBLIC WORKS CONSTRUCTION" (GREENBOOK), UNLESS OTHERWISE SHOWN. APPLY LIGHT BROOM FINISH TO ALL WALKWAYS. CONSTRUCT CONTROL JOINTS (WEAKENED PLANE JOINTS) AND EXPANSION JOINTS IN CURBS, GUTTERS, AND WALKS PER DETAILS ON SHEET C6.0.
3. HOT MIX ASPHALT (HMA) SHALL CONFORM TO THE REQUIREMENTS OF THE STATE OF CALIFORNIA DEPARTMENT OF TRANSPORTATION (CALTRANS) STANDARD SPECIFICATIONS FOR BE TYPE A, 1/2-INCH MAXIMUM SIZE AGGREGATE. ASPHALT BINDER SHALL BE PG 64-28.
4. AGGREGATE BASE SHALL BE 3/4" CLASS 2 AGGREGATE BASE PER STATE SPECIFICATIONS, SECTION 26. COMPACT TO 95% OF MAXIMUM DENSITY AS MEASURED BY ASTM D-1557.
5. ALL STORM DRAIN PIPE (6" AND LARGER) SHALL BE HIGH DENSITY POLYETHYLENE (HDPE) WITH SMOOTH INTERIOR CONFORMING WITH AASHTO M294 OR APPROVED EQUAL, UNLESS NOTED OTHERWISE.
6. ALL STORM DRAIN PIPE (4" AND SMALLER) SHALL BE POLYVINYL CHLORIDE (PVC) SCHEDULE 80, UNLESS NOTED OTHERWISE.
7. NEW AREA DRAINS SHALL BE COOK OR APPROVED EQUAL, GRATE SIZE AS NOTED. SHAPE BOTTOM TO DRAIN TO OUTLET WITH 4" MINIMUM THICKNESS OF CONCRETE. ALIGN CROWNS OF INLET AND OUTLETS PIPES, UNLESS NOTED OTHERWISE.
8. ALL UNDERGROUND UTILITIES SHALL BE INSTALLED WITH CLASS "A" TRENCH BACKFILL, SEE SHEET C6.0. GRAVEL BACKFILL SHALL BE COMPACTED TO 95% OF MAXIMUM DRY DENSITY AS MEASURED BY ASTM D-1557.
9. ALL GRADES SHOWN ARE FINISH GRADES. ALLOW FOR VARIOUS THICKNESS OF BASE, PAVING AND CONCRETE IN PREPARING SUBGRADE.
10. GRADE SITE TO THE GRADES SHOWN. COMPACT FILL AREAS AND TOP 6" OF CUT AREAS TO 95% OF MAXIMUM DENSITY AS MEASURED BY ASTM D-1557. IMPORT OR EXPORT AS NECESSARY.
11. ALL AREAS TO RECEIVE FILL ARE TO BE SCARIFIED A MINIMUM DEPTH OF 8", MOISTURE CONDITIONED, AND COMPACTED TO 95% OF MAXIMUM DENSITY AS MEASURED BY ASTM D-1557.



PERMIT SET

BAR IS ONE INCH ON ORIGINAL DRAWING
0' 1"
IF NOT ONE INCH ON THIS SHEET, ADJUST SCALES ACCORDINGLY.

REVISIONS		
NO	DATE	DESCRIPTION
1	9-9-24	DRIVEWAY ENTRANCE IMPROVEMENTS
2	9-18-24	PLAN CHECK REVISIONS

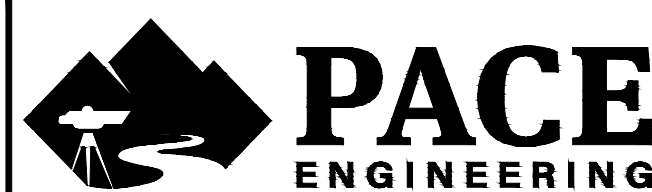

DES RT CKD TJ/SWg JOB NO.
DRN RT DATE 9/18/24 0470.22



SISKIYOU COUNTY GOVERNMENT CENTER
PARKING LOT IMPROVEMENTS

PHASE 1 GRADING PLAN

SHEET

C3.0

PG 5 OF 17

SYMBOL LEGEND

- AREA DRAIN
- BOLLARD
- CONDUIT
- △ CP# CONTROL POINT
- ◇ DOWNSPOUT
- ⤵ PIPE CULVERT/OUTLET
- ⊞ ELECTRICAL PANEL / BOX
- ⤵ GUY ANCHOR
- ⊞ POLE- JOINT UTILITY
- SANITARY SEWER MANHOLE
- ⊞ SIGN
- ⊞ UNKNOWN UTILITY VAULT
- ⊞ WATER METER/BOX
- ⊞ WATER VALVE

LINE LEGEND



- ===== VERTICAL CURB
- (E) EP
- (N) EP
- (E) CONC
- (N) CONC
- FLOWLINE
- E (N) ELECTRICAL LINE
- SD (N) STORM DRAIN LINE

HATCH LEGEND


- [Hatch] (E) CONCRETE
- [Hatch] (N) CONCRETE
- [Hatch] (E) PAVEMENT

ABBREVIATIONS

- AB AGGREGATE BASE
- AD AREA DRAIN
- CO CLEANOUT
- CONC CONCRETE
- CP CONTROL POINT
- DS DOWNSPOUT
- (E) EXISTING
- ELB ELBOW
- EL/ELEV ELEVATION
- ELEC ELECTRICAL
- FF FINISH FLOOR
- FP FINISH PAVEMENT
- FL FLOWLINE
- FG FINISH GRADE
- GR GRATE
- HMA HOT MIX ASPHALT
- INV INVERT
- LF LINEAL FEET
- MH MANHOLE
- (N) NEW
- S SLOPE
- SD STORM DRAIN
- SS SANITARY SEWER
- TBC TOP BACK OF CURB
- TC TOP OF CONCRETE
- TYP TYPICAL
- W/ WITH
- W WATER
- WV WATER VALVE

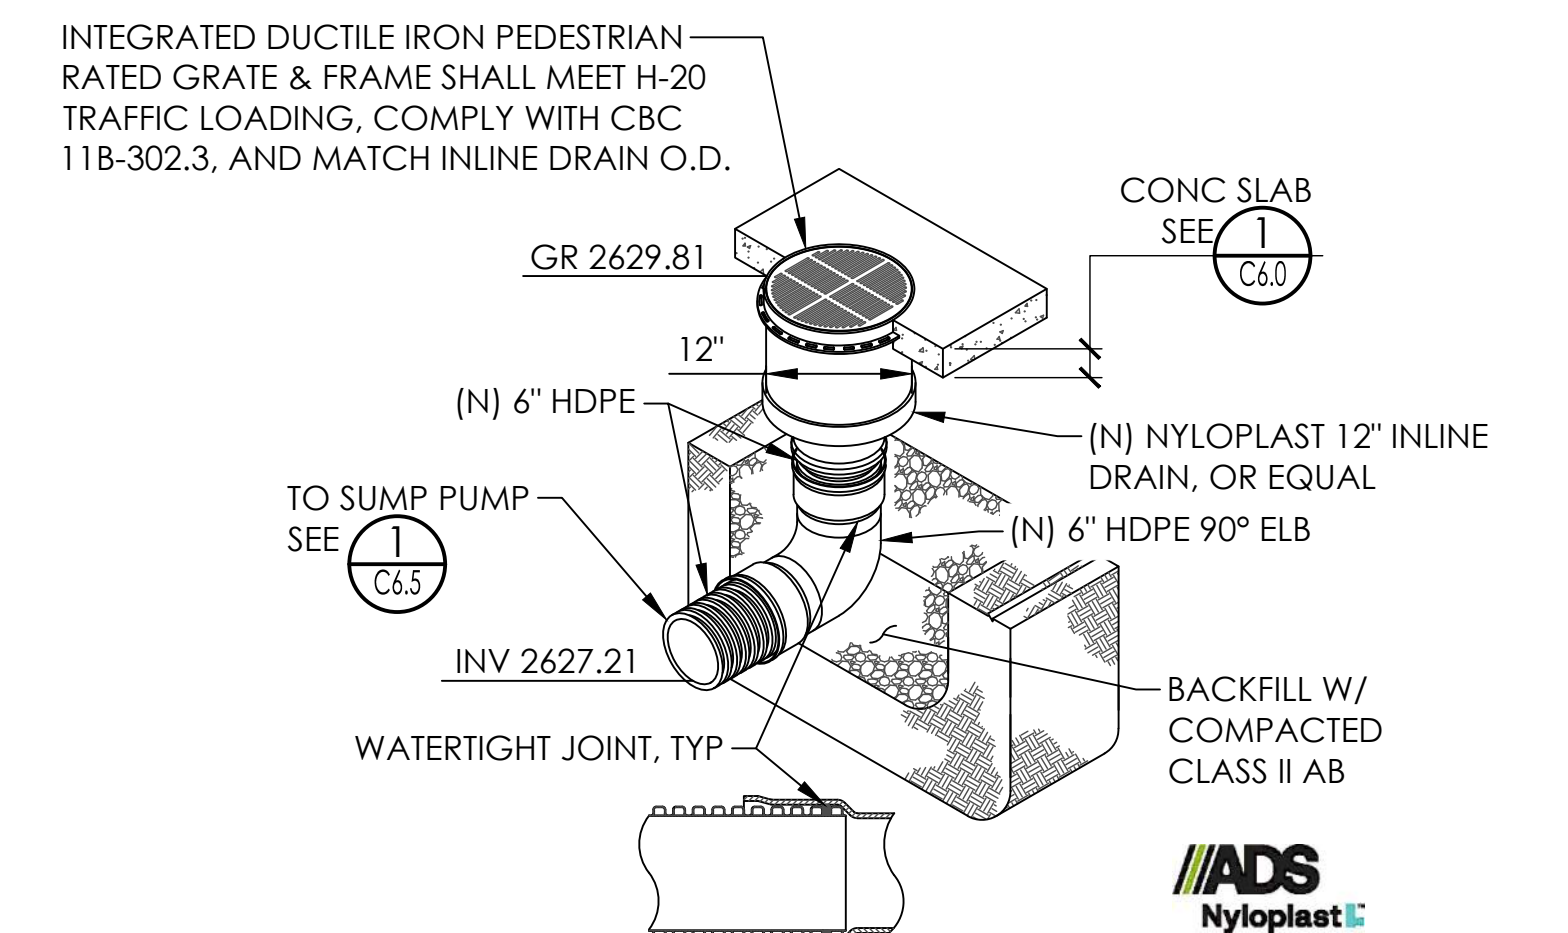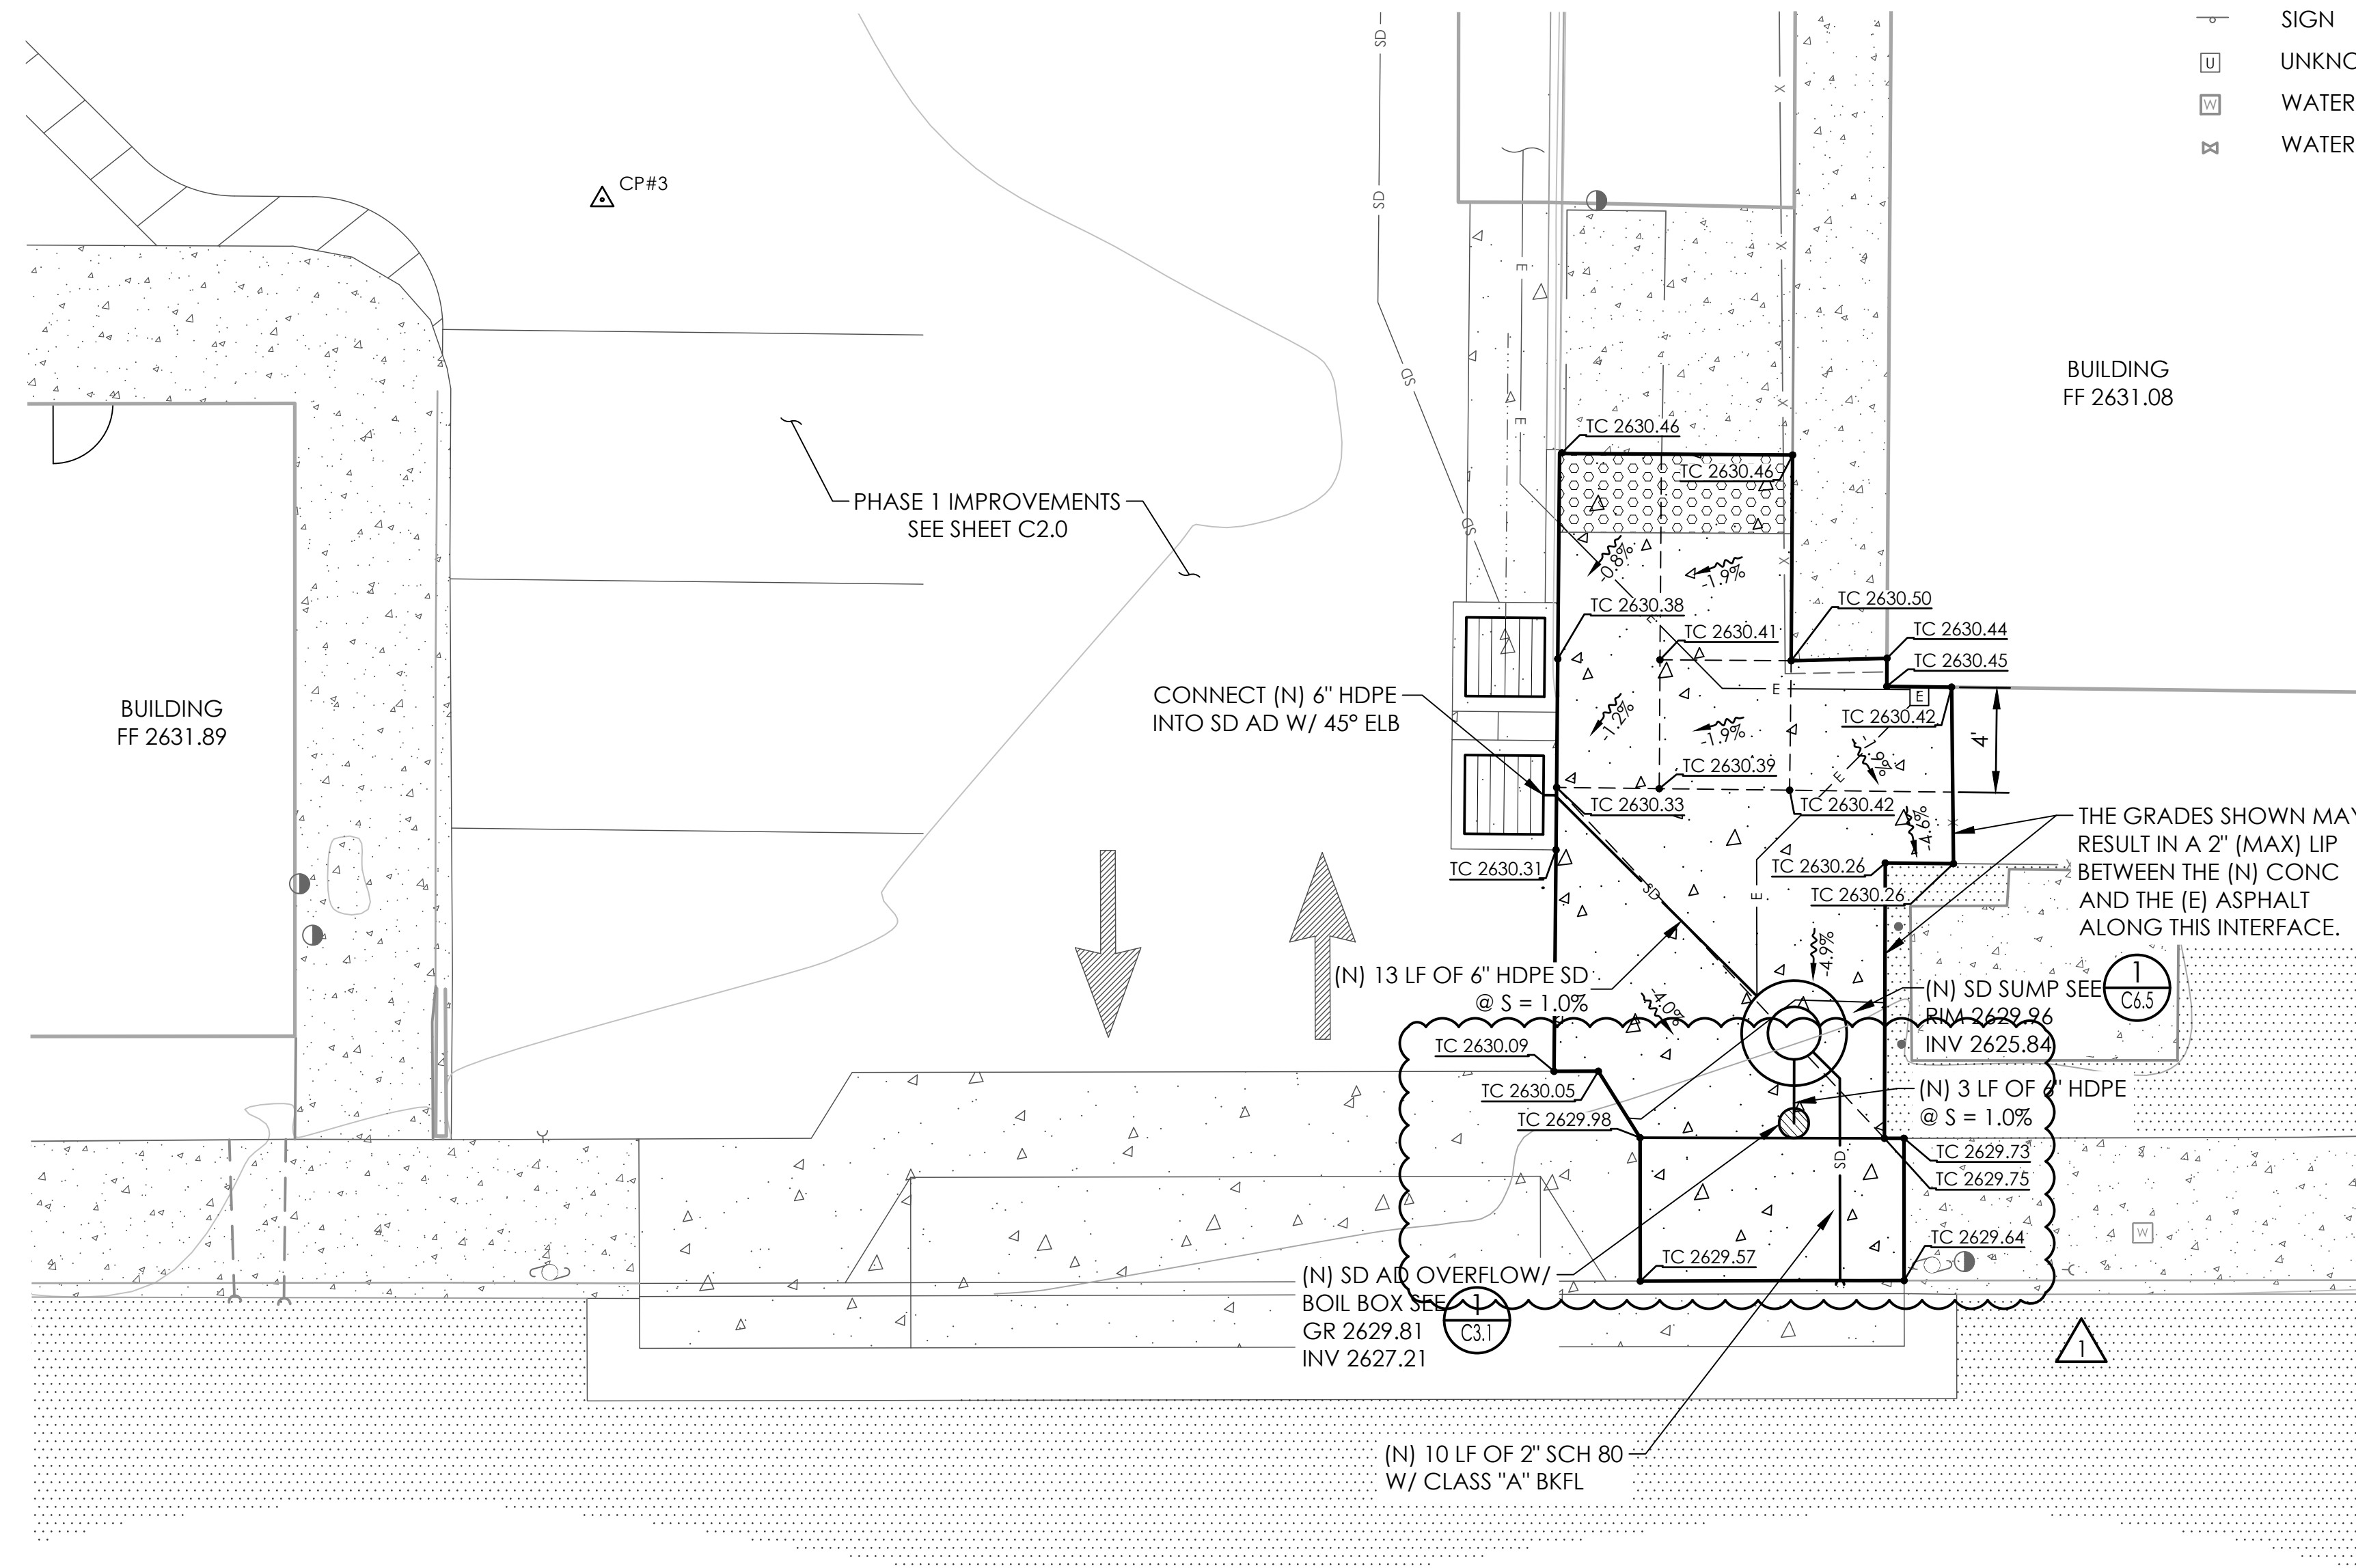

NYLOPLAST INLINE DRAIN W/ PEDESTRIAN GRATE
NTS (1) C3.1

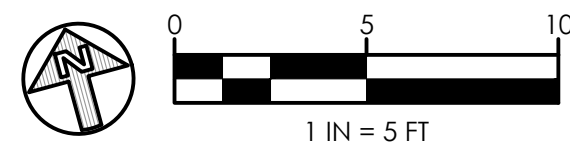

PERMIT SET

BAR IS ONE INCH ON ORIGINAL DRAWING
0' 1"
IF NOT ONE INCH ON THIS SHEET, ADJUST SCALES ACCORDINGLY.

REVISIONS		
NO	DATE	DESCRIPTION
1	9-9-24	DRIVEWAY ENTRANCE IMPROVEMENTS




DES RT CKD TJ/SWg JOB NO.
DRN RT DATE 9/10/24 0470.22



SISKIYOU COUNTY GOVERNMENT CENTER
PARKING LOT IMPROVEMENTS
PHASE 2 GRADING PLAN

SHEET
C3.1
PG 6 OF 17

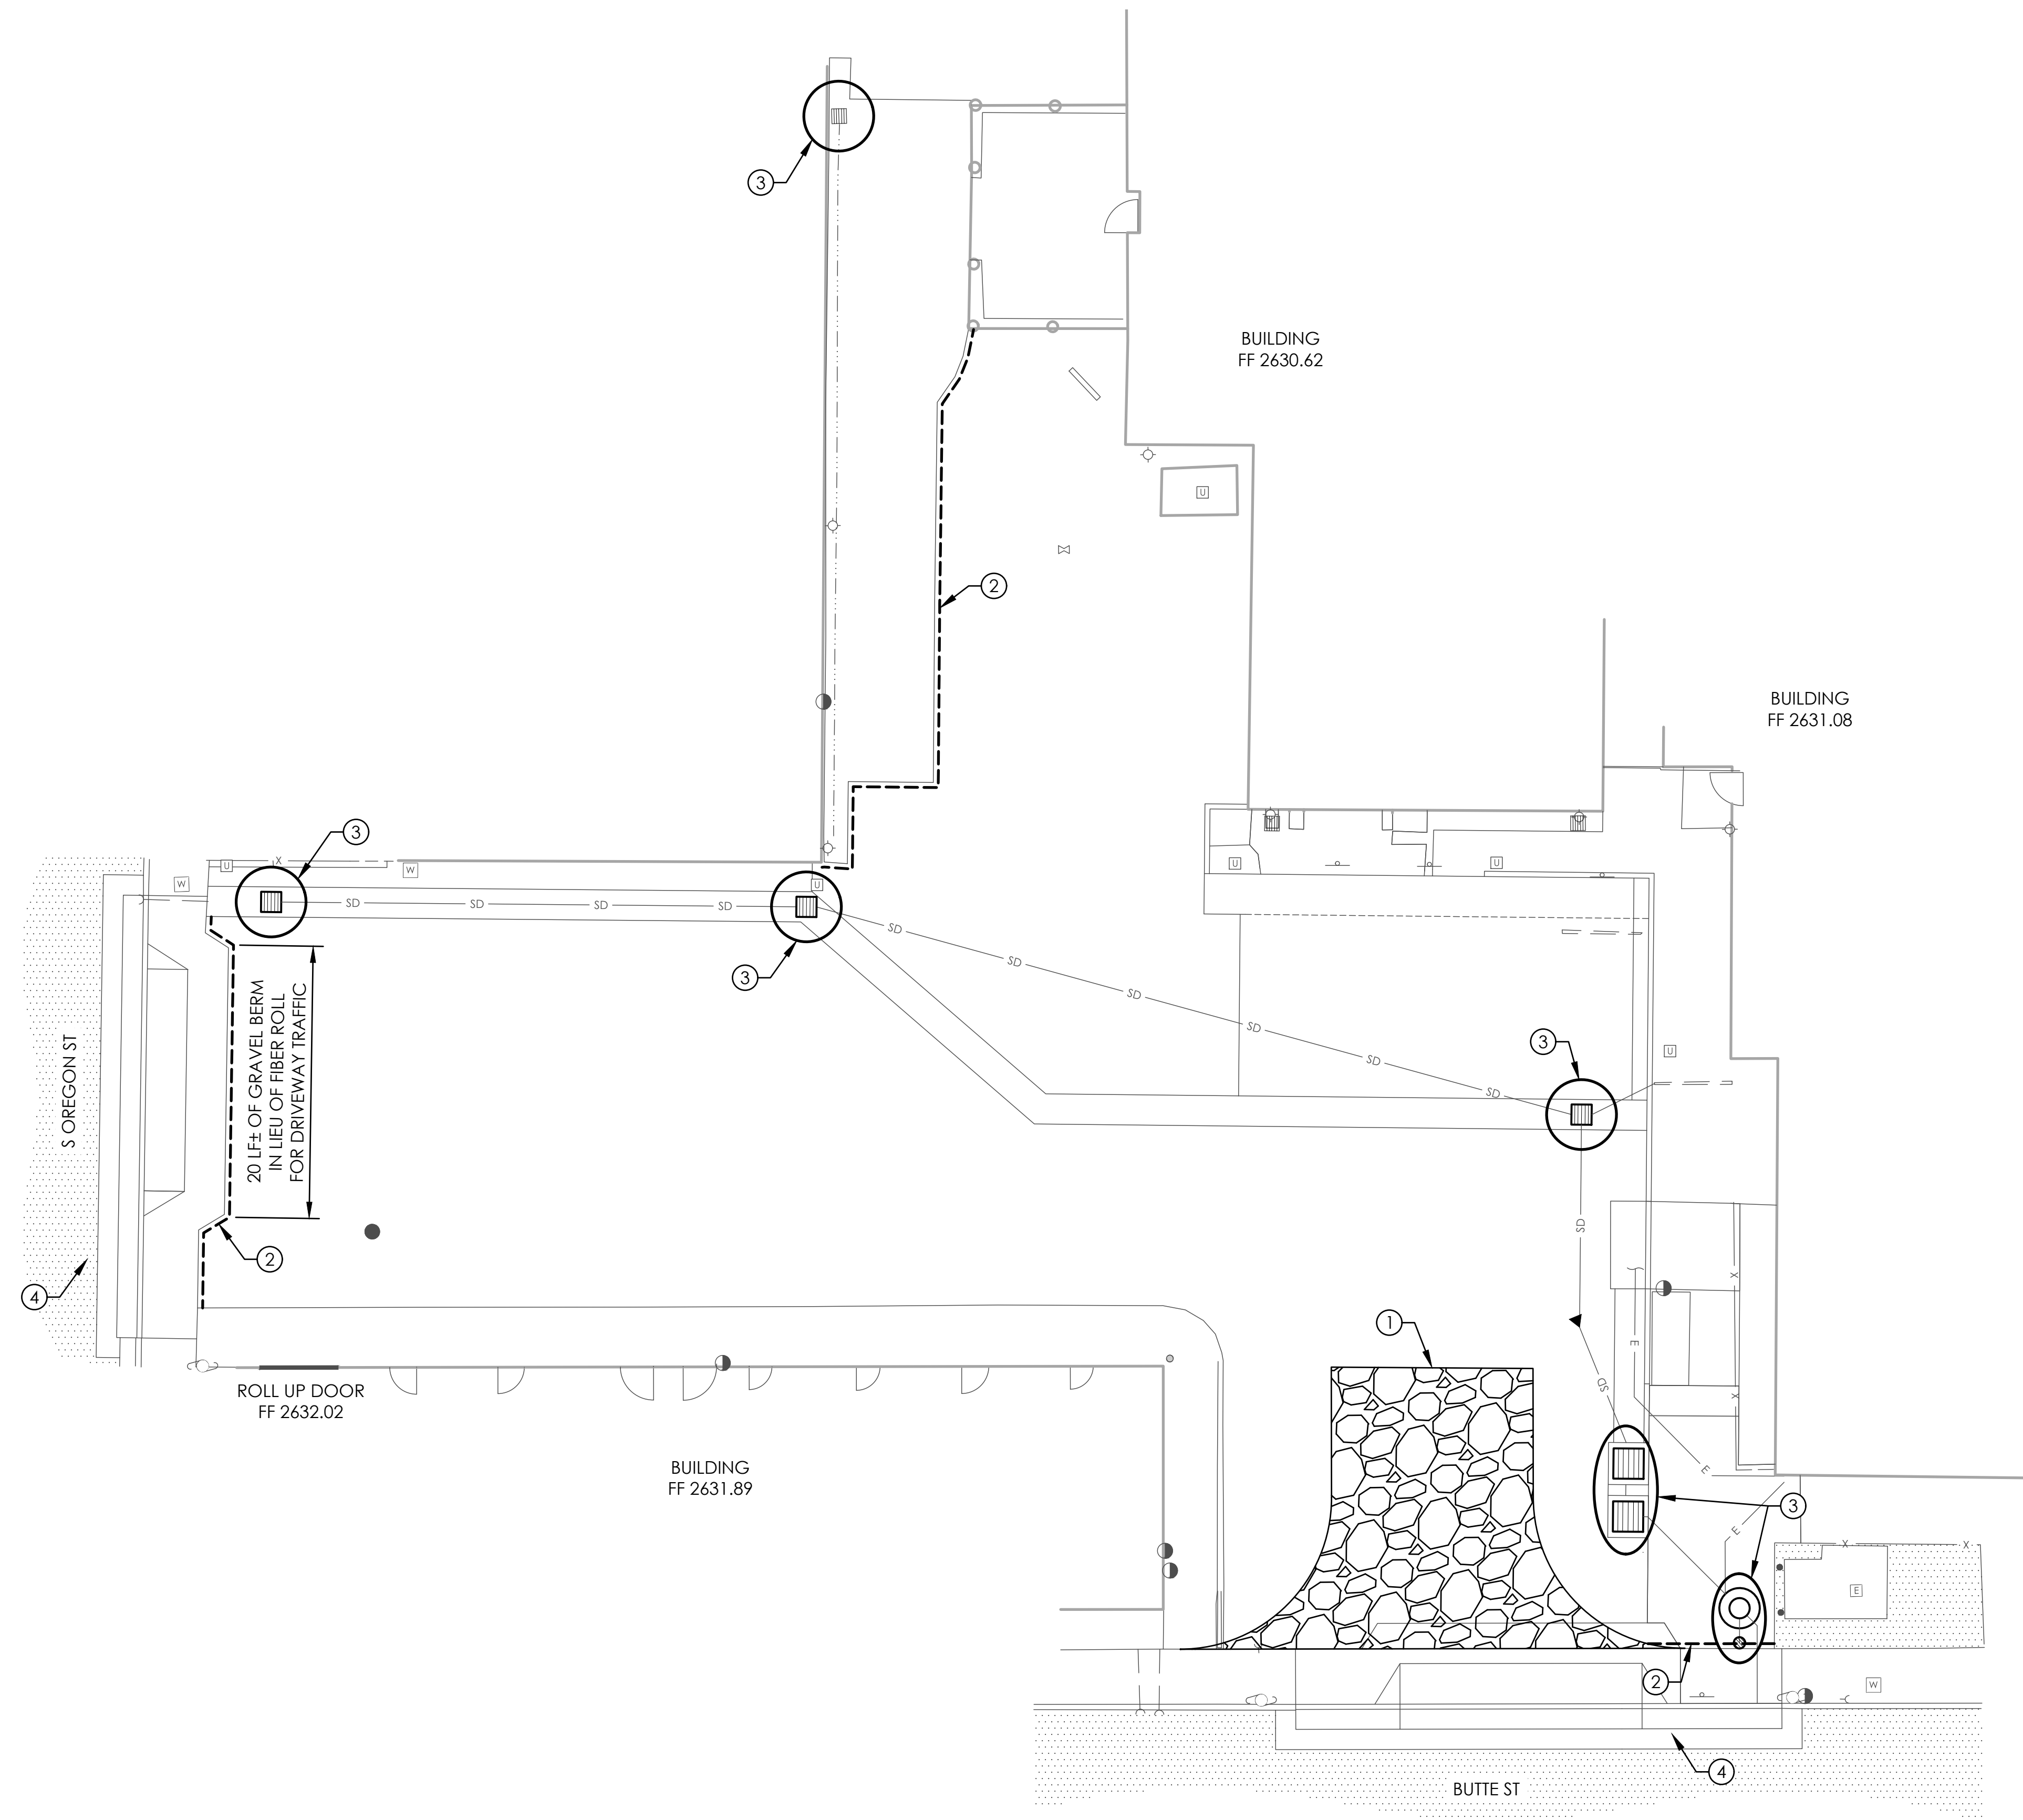


SYMBOL LEGEND

----- SEDIMENT BARRIER, SEE NOTE 2

■ AREA DRAIN

- NOTES:**
1. THE CONTRACTOR SHALL USE THE LOCATION SHOWN FOR THEIR EXIT OF THE WORK SITE AND INSTALL A TEMPORARY CONSTRUCTION ENTRANCE, PER DETAIL 6 SHEET C6.2, UNLESS THE SITE IS SURFACED WITH PAVEMENT OR AGGREGATE BASE.
 2. CONTRACTOR SHALL INSTALL A FIBER ROLL/GRAVEL BERM AND CREATE A 3" LIP BETWEEN THE EXITING CONCRETE EDGE AND UNFINISHED GRADE TO PREVENT SEDIMENT FROM LEAVING THE SITE, PER DETAIL 5 SHEET C6.2.
 3. CONTRACTOR SHALL CONSTRUCT GRAVEL BAG AREA DRAIN/DROP INLET SEDIMENT BARRIER PER DETAIL 7 SHEET C6.2, SUBSTITUTING GRAVEL BAGS FOR STRAW BALES.
 4. CONTRACTOR SHALL PERFORM SWEEP STREETS, AS NECESSARY, TO REMOVE ANY CONSTRUCTION DIRT THAT IS TRACKED ONTO THE PROJECT'S ADJACENT STREETS.
 5. CONTRACTOR SHALL SUBMIT A REVISED EROSION SEDIMENT CONTROL PLAN TO THE ENGINEER PRIOR TO CONSTRUCTION.
 6. ONCE CONSTRUCTION OF THE SITE IS COMPLETE BARRIERS AND DRAIN FILTER BAGS SHALL BE REMOVED.
 7. CONTRACTOR SHALL INSTALL ALL EROSION CONTROL BMP'S PRIOR TO CONSTRUCTION. OWNER IS RESPONSIBLE FOR VERIFYING THAT BMP'S REMAIN IN PLACE AND ARE FUNCTIONAL DURING CONSTRUCTION.

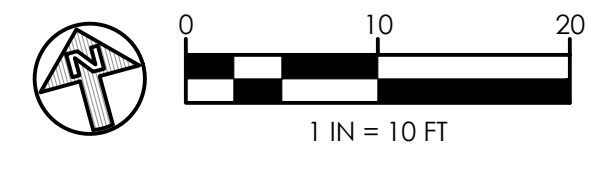


PERMIT SET

BAR IS ONE INCH ON ORIGINAL DRAWING

0' ————— 1'

IF NOT ONE INCH ON THIS SHEET, ADJUST SCALES ACCORDINGLY.

REVISIONS		
NO	DATE	DESCRIPTION

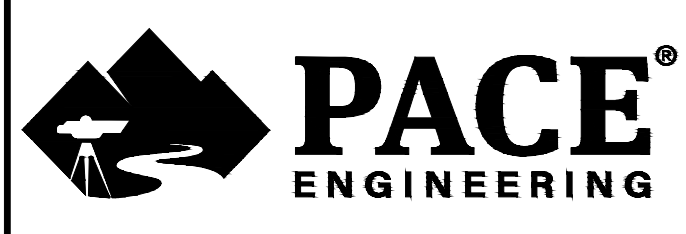

SIGNED 9/10/24

REGISTERED PROFESSIONAL ENGINEER

RYAN A. TURNER

No. 94742

CIVIL

STATE OF CALIFORNIA

DES	RT	CKD	TJ/SWg	JOB NO.
DRN	RT	DATE	9/10/24	0470.22

SISKIYOU COUNTY GOVERNMENT CENTER
PARKING LOT IMPROVEMENTS


EROSION SEDIMENT CONTROL PLAN

SHEET

C4.0

PG 7 OF 17

Plot Date: September 10, 2024 - 9:04 am. Login Name: rturner
 File Name: \\land\projects\47022_government_center_add_parking\01 CAD\05_CD\Erosion Control Plan\wg_Layout_ESCP

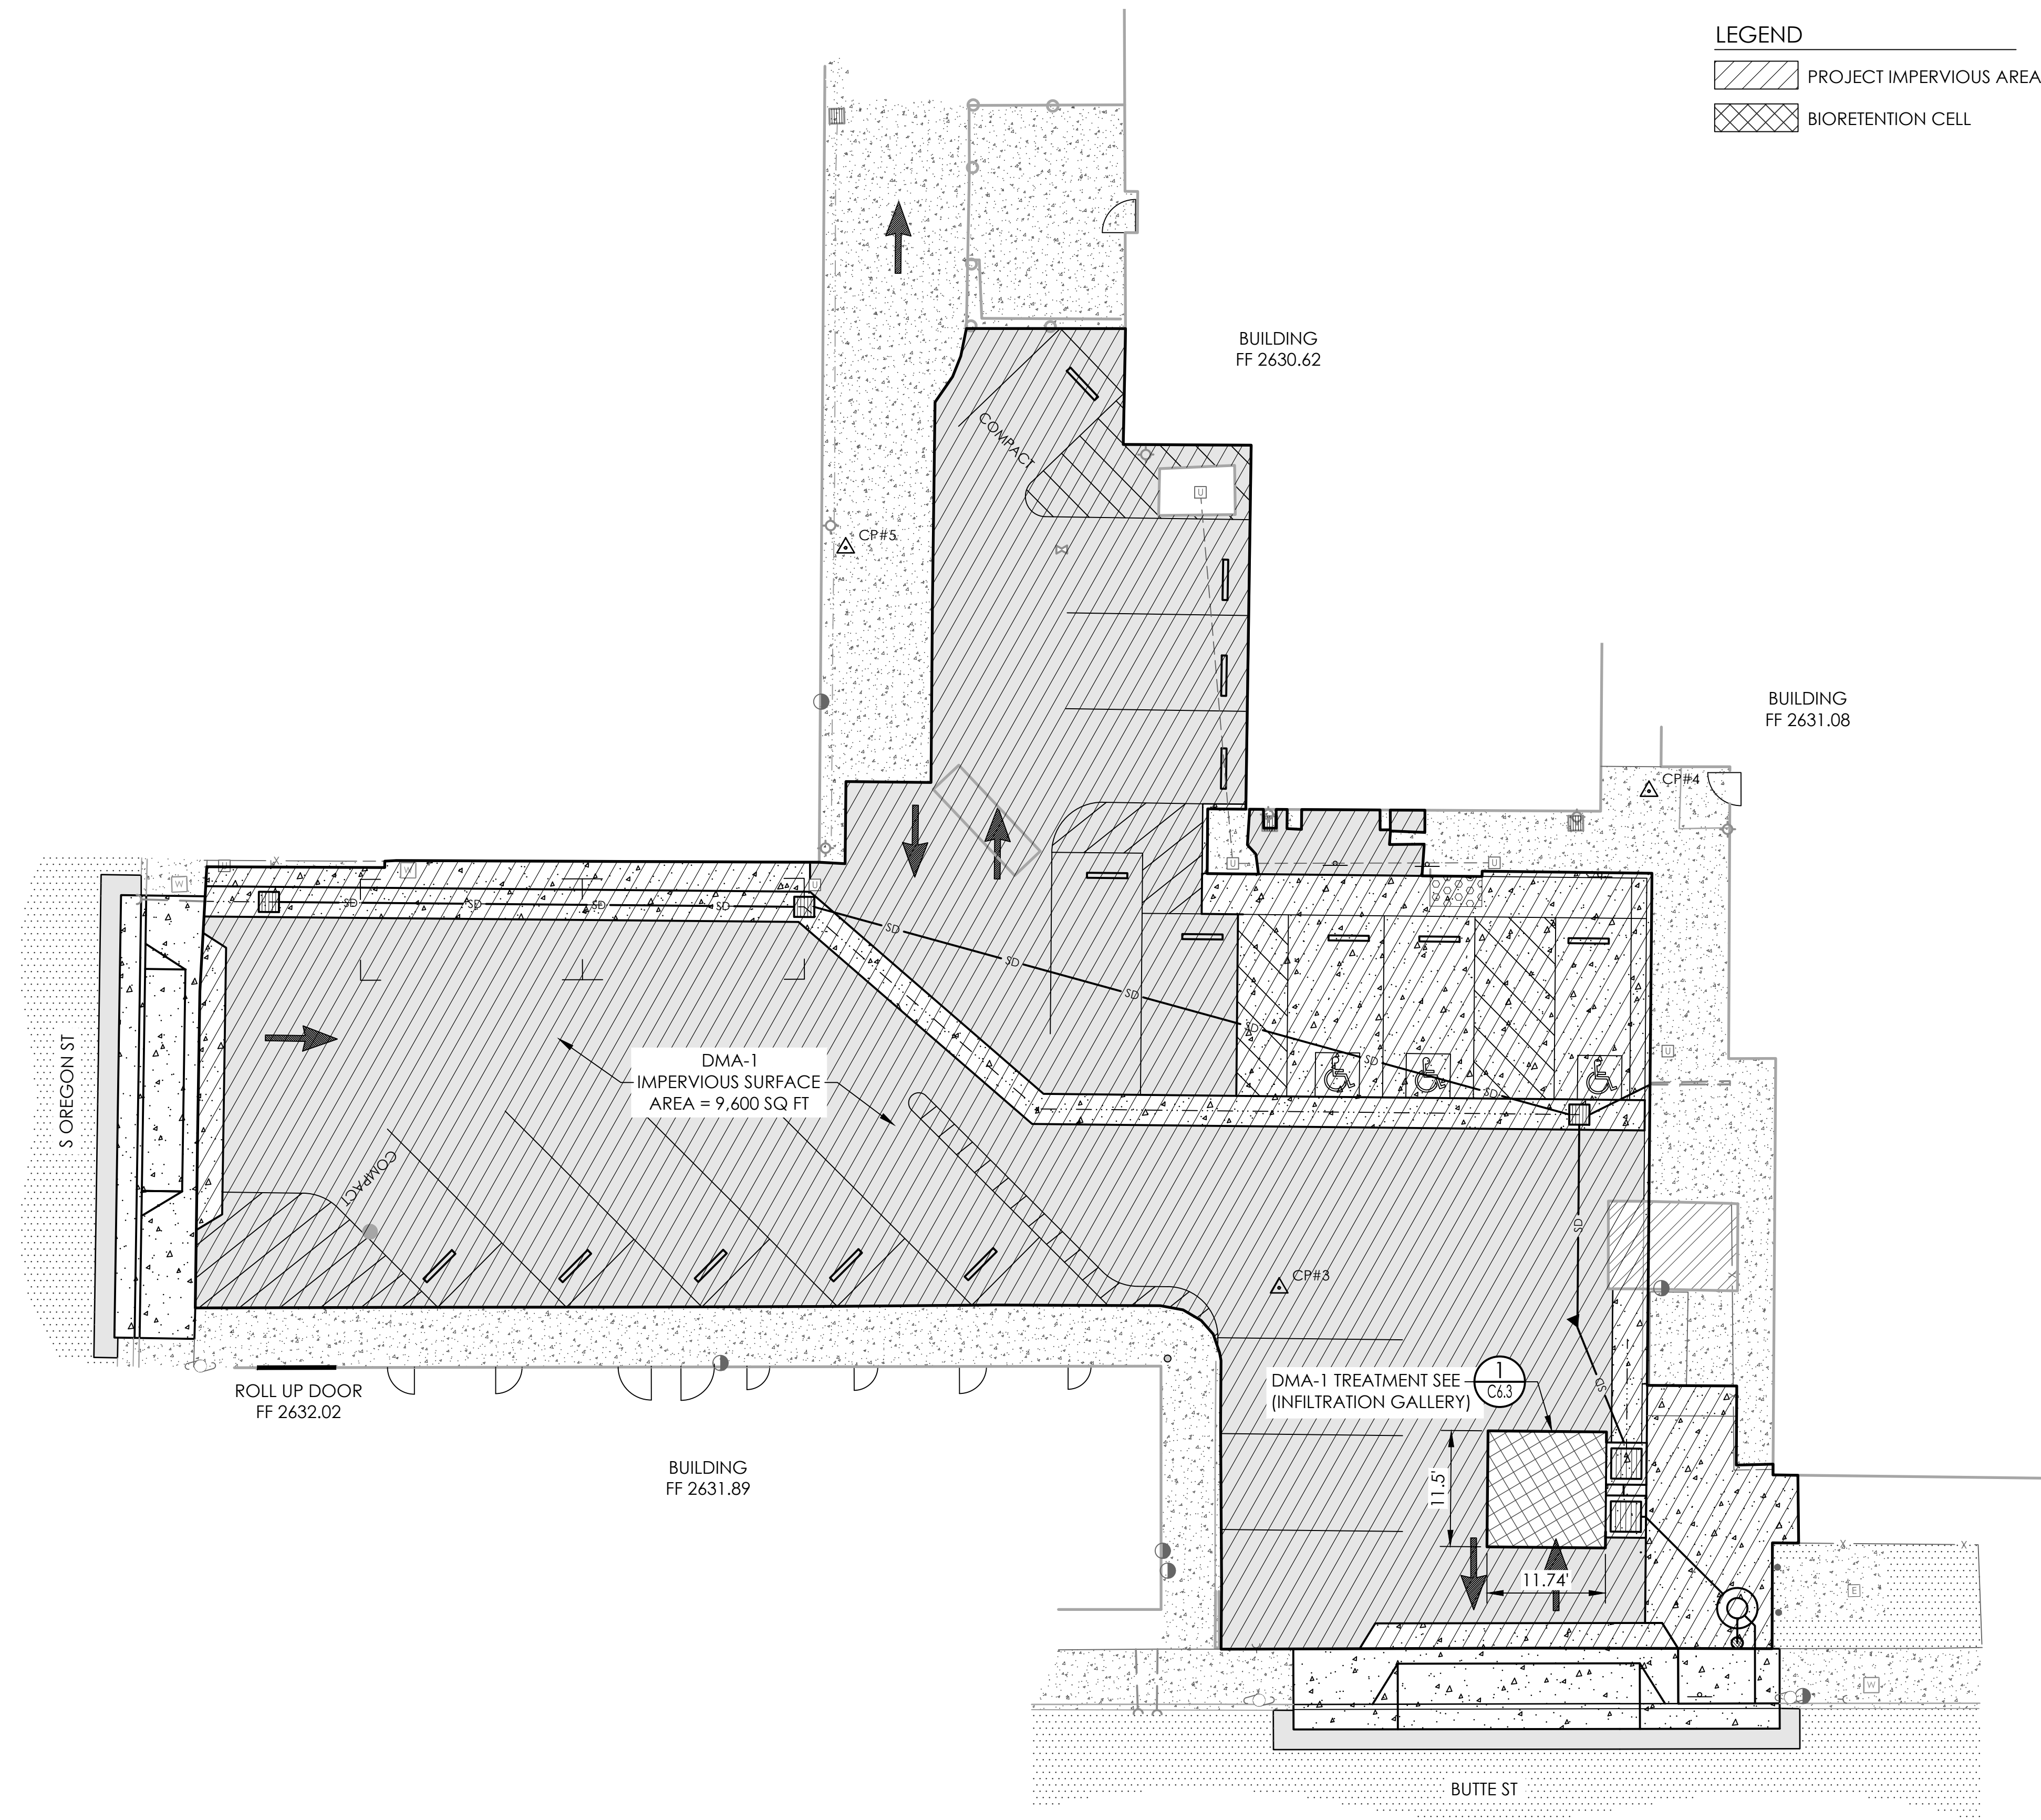

- LEGEND**
- PROJECT IMPERVIOUS AREA
 - BIORETENTION CELL


- MS4 NOTES**
1. FOR GRADING INFORMATION NOT SHOWN, SEE GRADING PLAN, SHEET C3.0.
 2. INSPECT EVERY 6 MONTHS DURING THE FIRST YEAR OF OPERATION. ADJUST THE INSPECTION INTERVAL BASED ON PREVIOUS OBSERVATIONS OF SEDIMENT ACCUMULATION AND HIGH WATER ELEVATIONS.
 3. CONDUCT JETTING AND VACTORING ANNUALLY OR WHEN INSPECTION SHOWS THAT MAINTENANCE IS NECESSARY.

- INSPECTION AND MAINTENANCE NOTES**
- STEP 1) INSPECT ISOLATOR ROW PLUS FOR SEDIMENT
- A. INSPECTION PORTS
 - A.1. REMOVE/OPEN LID ON NYLOPLAST INLINE DRAIN
 - A.2. REMOVE AND CLEAN FLEXSTORM FILTER IF INSTALLED
 - A.3. USING A FLASHLIGHT AND STADIA ROD, MEASURE DEPTH OF SEDIMENT AND RECORD ON MAINTENANCE LOG
 - A.4. LOWER A CAMERA INTO ISOLATOR ROW PLUS FOR VISUAL INSPECTION OF SEDIMENT LEVELS (OPTIONAL)
 - A.5. IF SEDIMENT IS AT, OR ABOVE, 3" (80 mm) PROCEED TO STEP 2. IF NOT, PROCEED TO STEP 3.
 - B. ALL ISOLATOR PLUS ROWS
 - B.1. REMOVE COVER FROM STRUCTURE AT UPSTREAM END OF ISOLATOR ROW PLUS
 - B.2. USING A FLASHLIGHT, INSPECT DOWN THE ISOLATOR ROW PLUS THROUGH OUTLET PIPE
 - i) MIRRORS ON POLES OR CAMERAS MAY BE USED TO AVOID A CONFINED SPACE ENTRY
 - ii) FOLLOW OSHA REGULATIONS FOR CONFINED SPACE ENTRY IF ENTERING MANHOLE
 - B.3. IF SEDIMENT IS AT, OR ABOVE, 3" (80 mm) PROCEED TO STEP 2. IF NOT, PROCEED TO STEP 3.
- STEP 2) CLEAN OUT ISOLATOR ROW PLUS USING THE JETVAC PROCESS
- A. A FIXED CULVERT CLEANING NOZZLE WITH REAR FACING SPREAD OF 45" (1.1 m) OR MORE IS PREFERRED
 - B. APPLY MULTIPLE PASSES OF JETVAC UNTIL BACKFLUSH WATER IS CLEAN
 - C. VACUUM STRUCTURE SUMP AS REQUIRED
- STEP 3) REPLACE ALL COVERS, GRATES, FILTERS, AND LIDS; RECORD OBSERVATIONS AND ACTIONS.
- STEP 4) INSPECT AND CLEAN BASINS AND MANHOLES UPSTREAM OF THE STORMTECH SYSTEM.

- POST CONSTRUCTION BMP DESIGN**
1. APPLICABLE STANDARDS:
HUMBOLDT COUNTY LOW IMPACT DEVELOPMENT STORMWATER MANUAL
 2. PROJECT CLASSIFICATION: REGULATED PROJECT (OVER 5,000 SQ FT)
 3. ANALYSIS TOOL:
CALIFORNIA PHASE II LID SIZING TOOL
 4. TREE CREDITS:
EXISTING CANOPY: NO CREDITS TAKEN
NEW: NO CREDITS INCLUDED
 5. LID SIZING INPUT PARAMETERS:

DMA-1:
RAIN GAUGE: YREKA
SATURATED HYDRAULIC CONDUCTIVITY: 1.0 IN/HR
NEW IMPERVIOUS AREA: 9,600 SQ FT
DESIGN METHOD: DESIGN STORM
 6. RESULTS:

DMA-1:
BMP CHOSEN: INFILTRATION GALLERY. RUNOFF FROM IMPERVIOUS PARKING LOT FLOWS THROUGH THE INFILTRATION GALLERY.
VEGETATED BASIN NEEDED: 113 SQ FT
VEGETATED BASIN PROVIDED: 135 SQ FT
PERCENT COMPLIANT LID BMP AREA: 119%

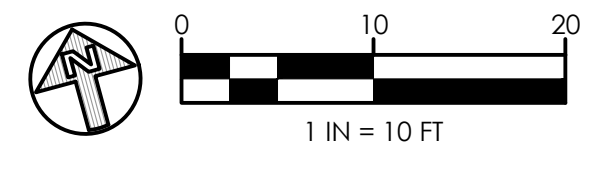

PERMIT SET

BAR IS ONE INCH ON ORIGINAL DRAWING
0" 1"
IF NOT ONE INCH ON THIS SHEET, ADJUST SCALES ACCORDINGLY.

REVISIONS		
NO	DATE	DESCRIPTION

PACE ENGINEERING

DES: RT CKD: TJSWg JOB NO. 0470.22
DRN: RT DATE: 9/10/24

SIGNED 9/10/24


REGISTERED PROFESSIONAL ENGINEER
RYAN A. TURNER
No. 94742
CIVIL
STATE OF CALIFORNIA

SISKIYOU COUNTY GOVERNMENT CENTER
PARKING LOT IMPROVEMENTS

POST CONSTRUCTION STANDARDS PLAN


SHEET
C5.0
PG 8 OF 17

Plot Date: September 10, 2024 - 9:04 am. Login Name: rturner
File Name: M:\land projects\047022_government_center_parking\01 CAD\05 CD\POSTSTAND Layout.MXD

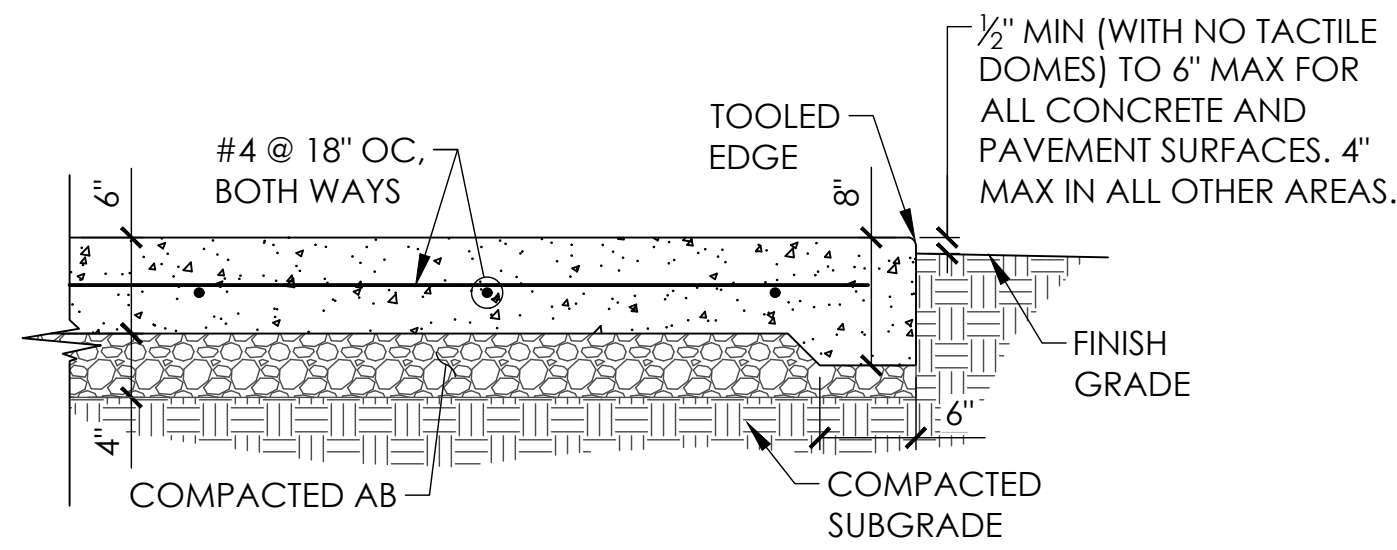


- NOTES:
1. CONCRETE SHALL BE PER NOTE 2 ON SHEET C3.0.
 2. PROVIDE A EXPANSION JOINTS AT 12' O.C. MAX PER DETAIL 5 ON SHEET C6.0.
 3. APPLY A LIGHT BROOM FINISH IN THE DIRECTION OF FLOW.

CONCRETE SLAB DETAIL
NTS (1)
C6.0

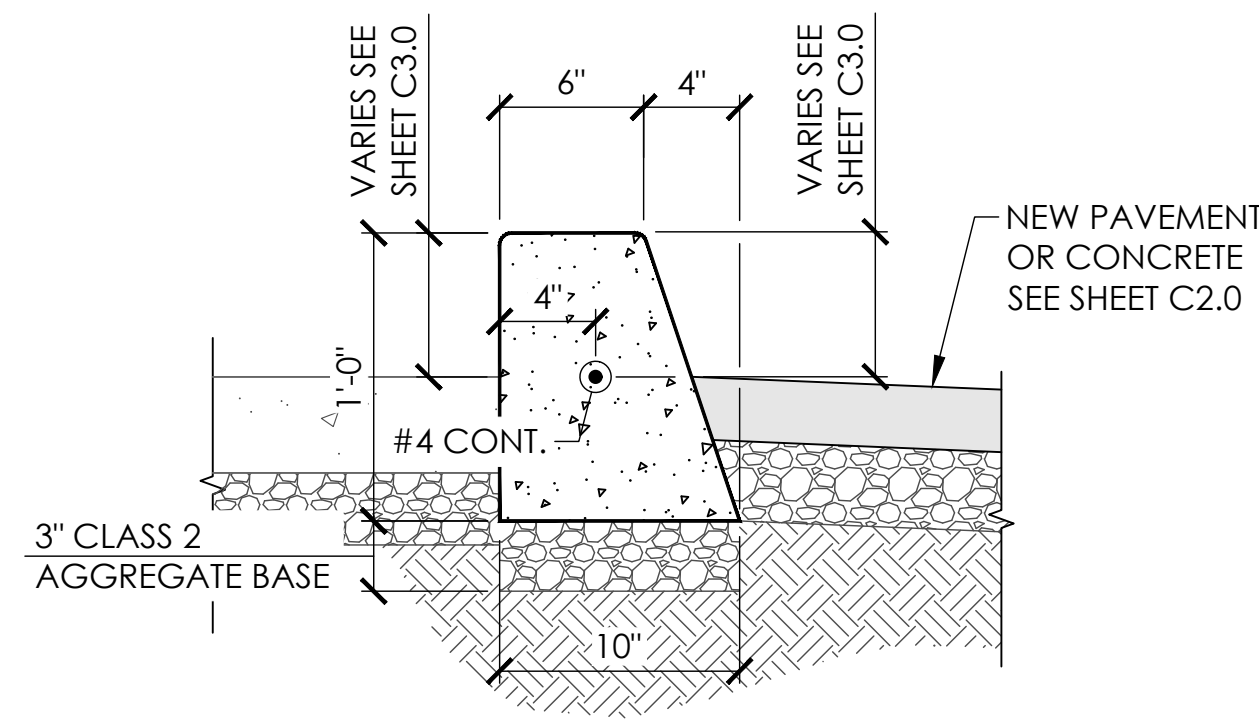


- NOTES:
1. CONCRETE SHALL BE PER NOTE 2 ON SHEET C3.0.
 2. PROVIDE A CONTROL JOINT AT 12 FT. O.C. MAX AND AN EXPANSION JOINT AT ALL BC/EC'S PER DETAIL 5 ON SHEET C6.0.
 3. ALL EXPOSED SURFACES SHALL RECEIVE A LIGHT BROOM FINISH PARALLEL TO THE CURB.

CONC CURB DETAIL
NTS (2)
C6.0

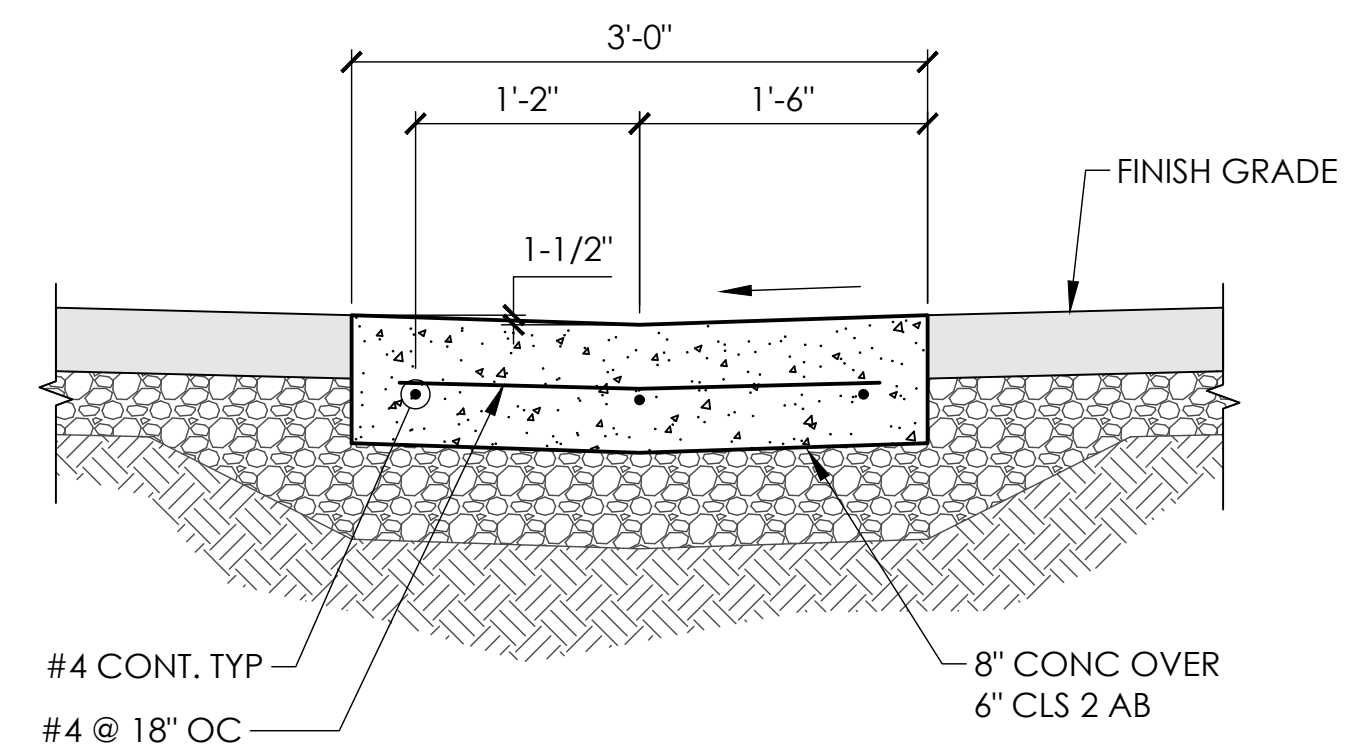


- NOTES:
1. CONCRETE SHALL BE PER NOTE 2 ON SHEET C3.0.
 2. PROVIDE A CONTROL JOINT AT 12 FT. O.C. MAX AND AN EXPANSION JOINT AT ALL ANGLE POINTS PER DETAIL 5 ON SHEET C6.0.
 3. ALL EXPOSED SURFACES SHALL RECEIVE A LIGHT BROOM FINISH PARALLEL TO THE DIRECTION OF FLOW.

CONCRETE VALLEY GUTTER DETAIL
NTS (3)
C6.0

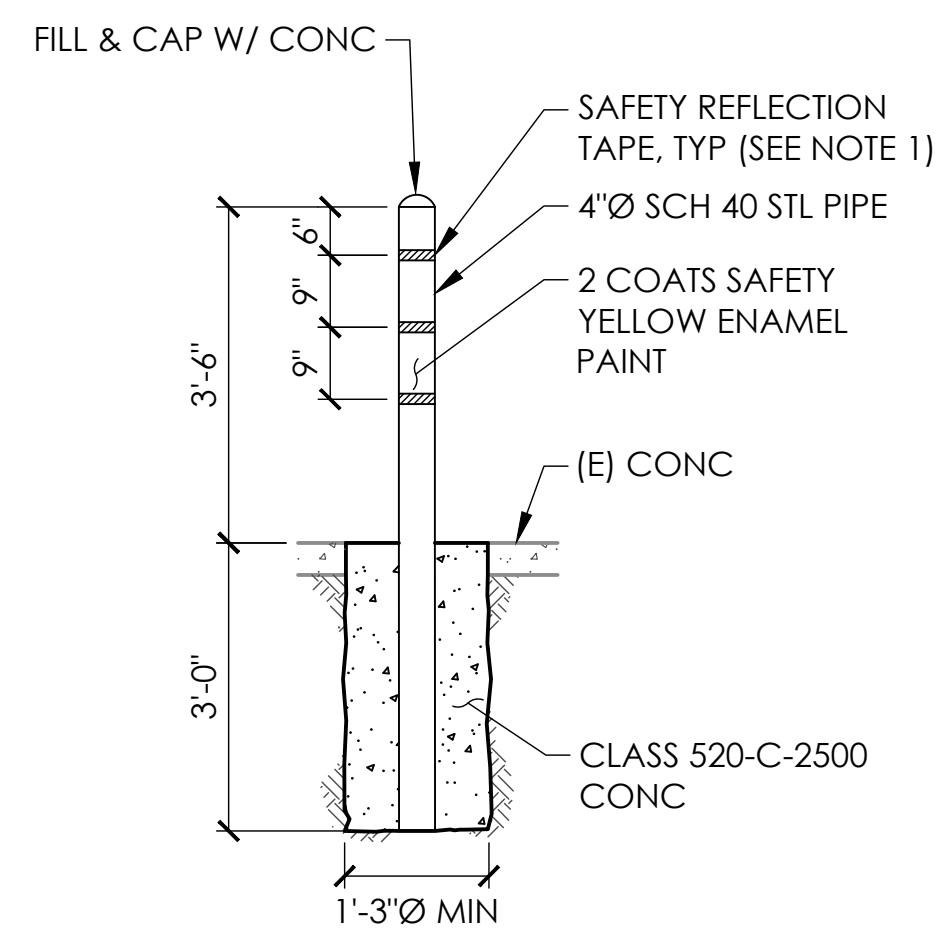


- NOTES:
1. 3" WIDE BLUE REFLECTOR TAPE SHALL BE USED FOR FIRE PROTECTION DEVICES. 1" WIDE SAFETY REFLECTION TAPE SHALL BE USED AT ALL OTHER LOCATIONS. TAPE SHALL BE SUITABLE FOR ALL WEATHER, & CHEMICAL & ABRASION RESISTANT.

BOLLARD DETAIL
NTS (4)
C6.0

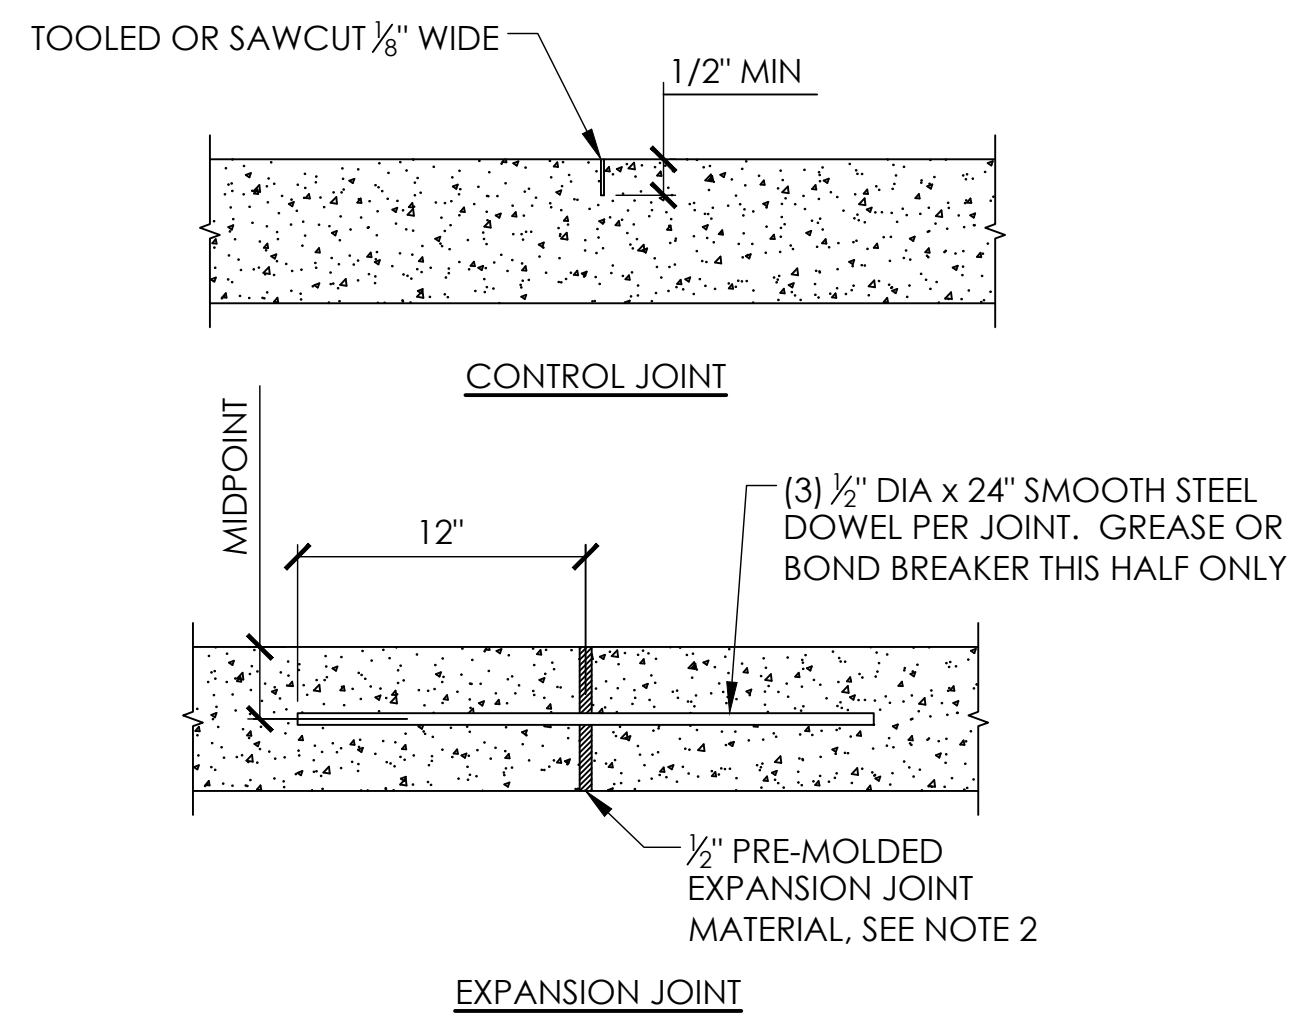


- NOTES:
1. 1/2 INCH PRE-MOLDED JOINT MATERIAL SHALL BE HELD FIRMLY IN PLACE PRIOR TO PLACING CONCRETE.
 2. EXPANSION JOINTS SHALL BE INSTALLED AT THE BEGINNING AND END OF ALL CURB/WALK RETURNS.
 3. FOR WALKWAYS, EXPANSION JOINTS SHALL BE INSTALLED AT INTERVALS NOT TO EXCEED 50' MAX OC.
 3. CONTROL JOINTS SHALL BE AT 5' OC MAX IN SIDEWALKS, 12' OC MAX IN CURBS AND GUTTERS.

CONC JOINT DETAIL
NTS (5)
C6.0

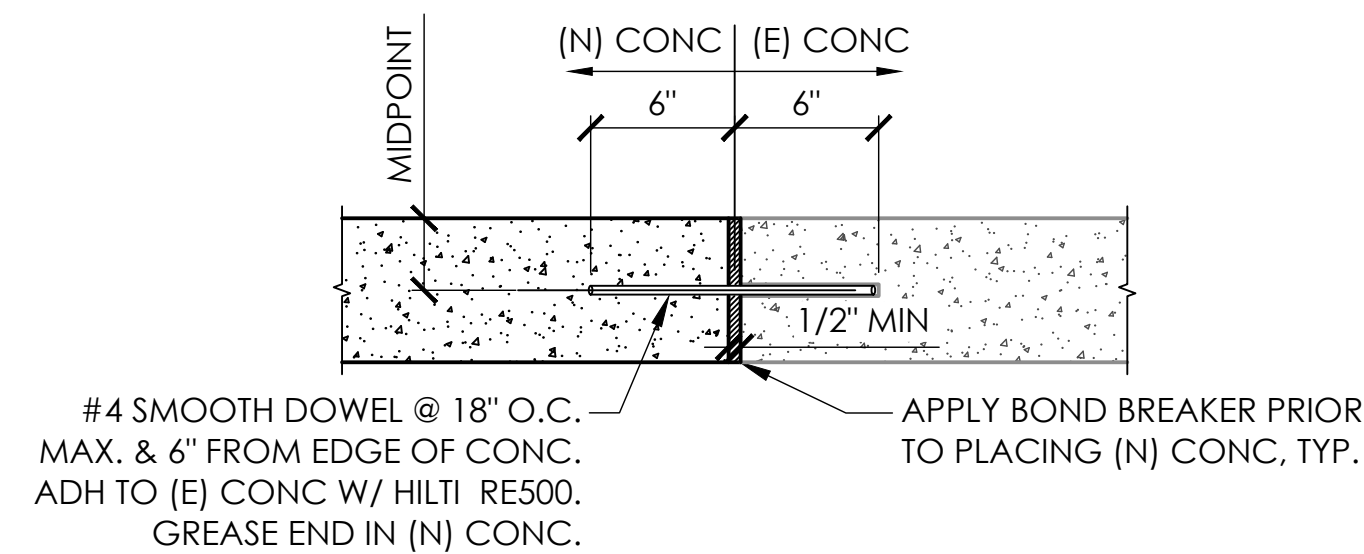


- NOTES:
1. CONCRETE SHALL BE PER NOTE 2 ON SHEET C3.0.

(E) CONC TO (N) CONC DETAIL
NTS (6)
C6.0

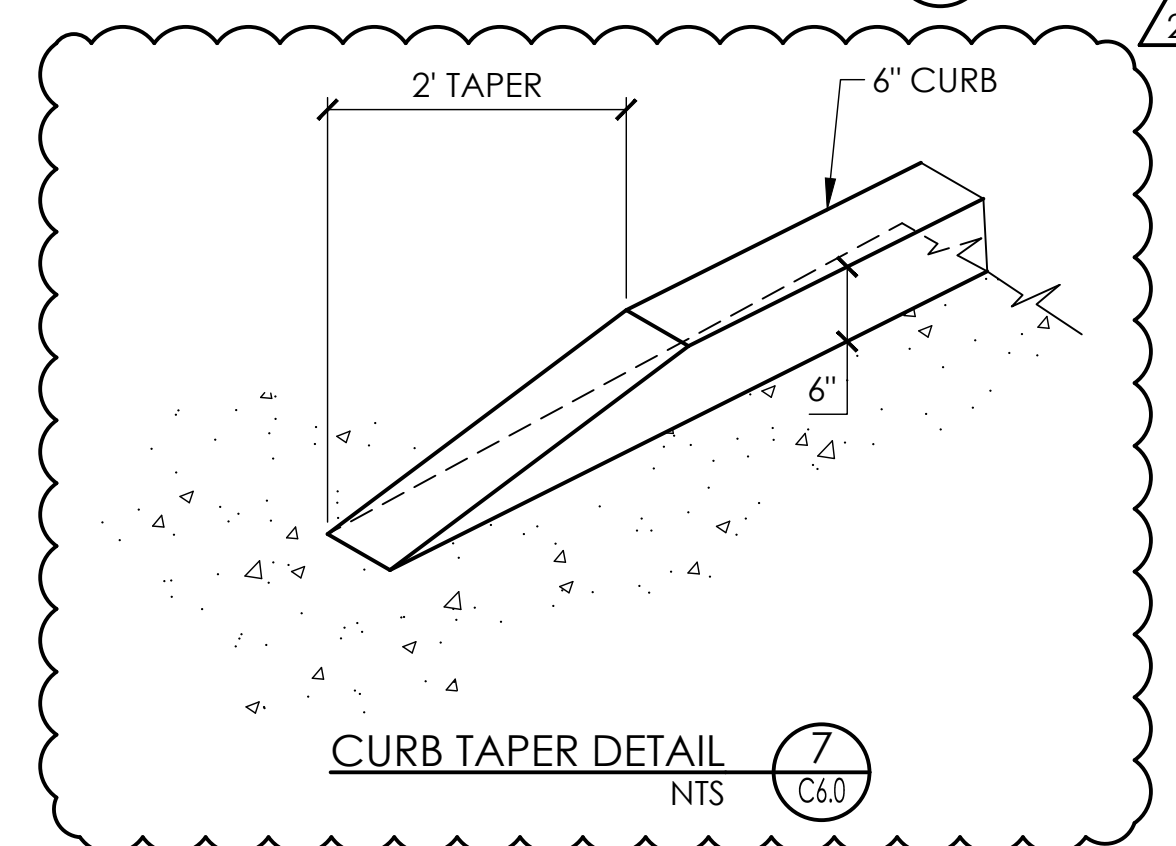

CURB TAPER DETAIL
NTS (7)
C6.0

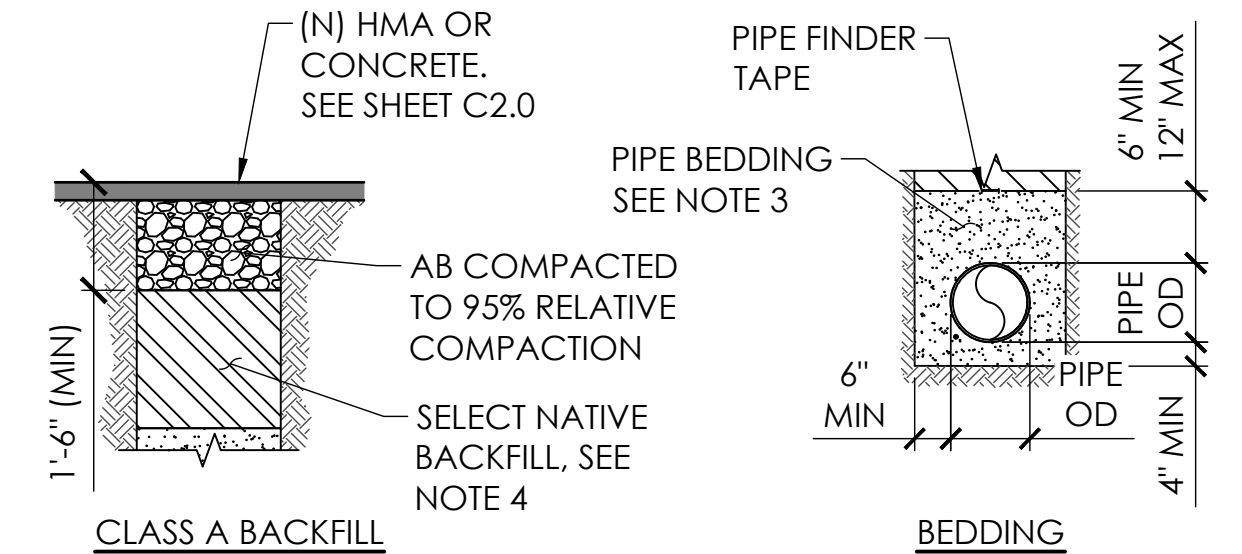

- NOTES:
1. CLASS "A3" BKFL SHALL BE USED IN ALL PAVED OR CONCRETE AREAS.
 2. FOR 2 PIPES IN COMMON TRENCH, MAINTAIN 12 IN CLEARANCE BETWEEN PIPES & 6 IN MIN BETWEEN PIPES & TRENCH WALL.
 3. PIPE BEDDING SHALL ATSM C33 SAND FOR ALL UNDERGROUND UTILITIES COMPACTED TO 90% RELATIVE COMPACTION.
 4. SELECT NATIVE BACKFILL SHALL CONSIST OF WELL GRADED 3-INCH MINUS NATIVE MATERIAL, FREE FROM ORGANIC MATERIAL, AND COMPACTED TO 90% RELATIVE COMPACTION. CLASS 2 AGGREGATE BASE MAY BE USED AS AN ALTERNATIVE IF DESIRED BY THE CONTRACTOR.

TRENCHING STANDARD DETAIL
NTS (8)
C6.0

PERMIT SET

BAR IS ONE INCH ON ORIGINAL DRAWING
0" 1"
IF NOT ONE INCH ON THIS SHEET, ADJUST SCALES ACCORDINGLY.

REVISIONS		
NO	DATE	DESCRIPTION
2	9-18-24	PLAN CHECK REVISIONS

PACE ENGINEERING



DES: RT CKD: TJS/Wg JOB NO. DRN: RT DATE: 9/18/24 0470.22

SIGNED 9/18/24

REGISTERED PROFESSIONAL ENGINEER
RYAN A. TURNER
No. 94742
CIVIL
STATE OF CALIFORNIA


SISKIYOU COUNTY GOVERNMENT CENTER
PARKING LOT IMPROVEMENTS
STANDARD DETAILS

SHEET
C6.0
PG 9 OF 17

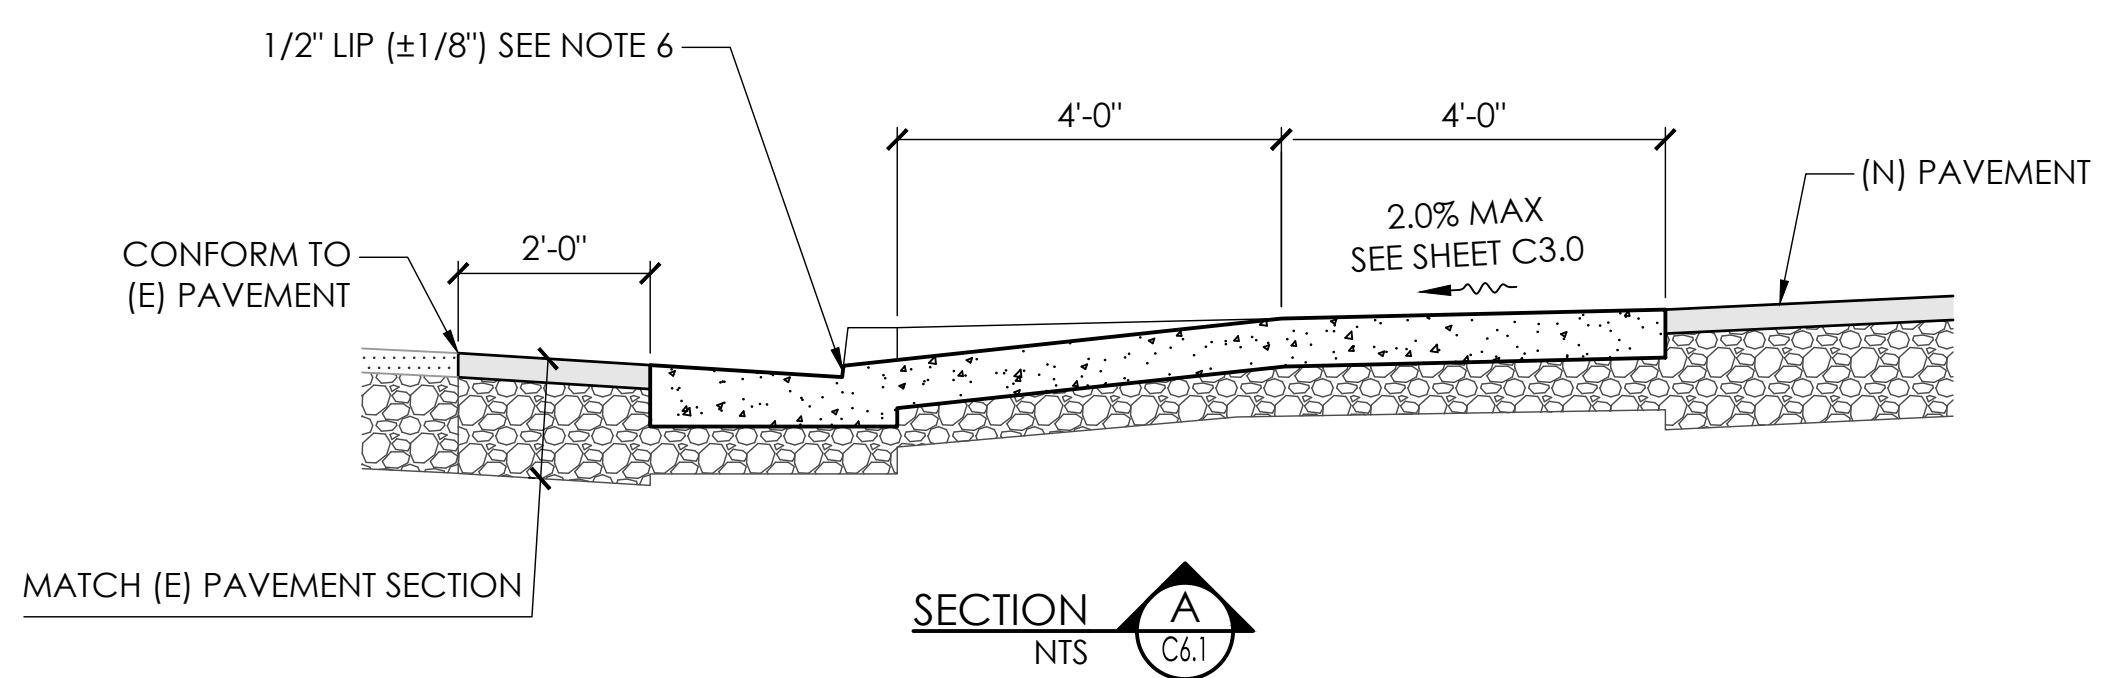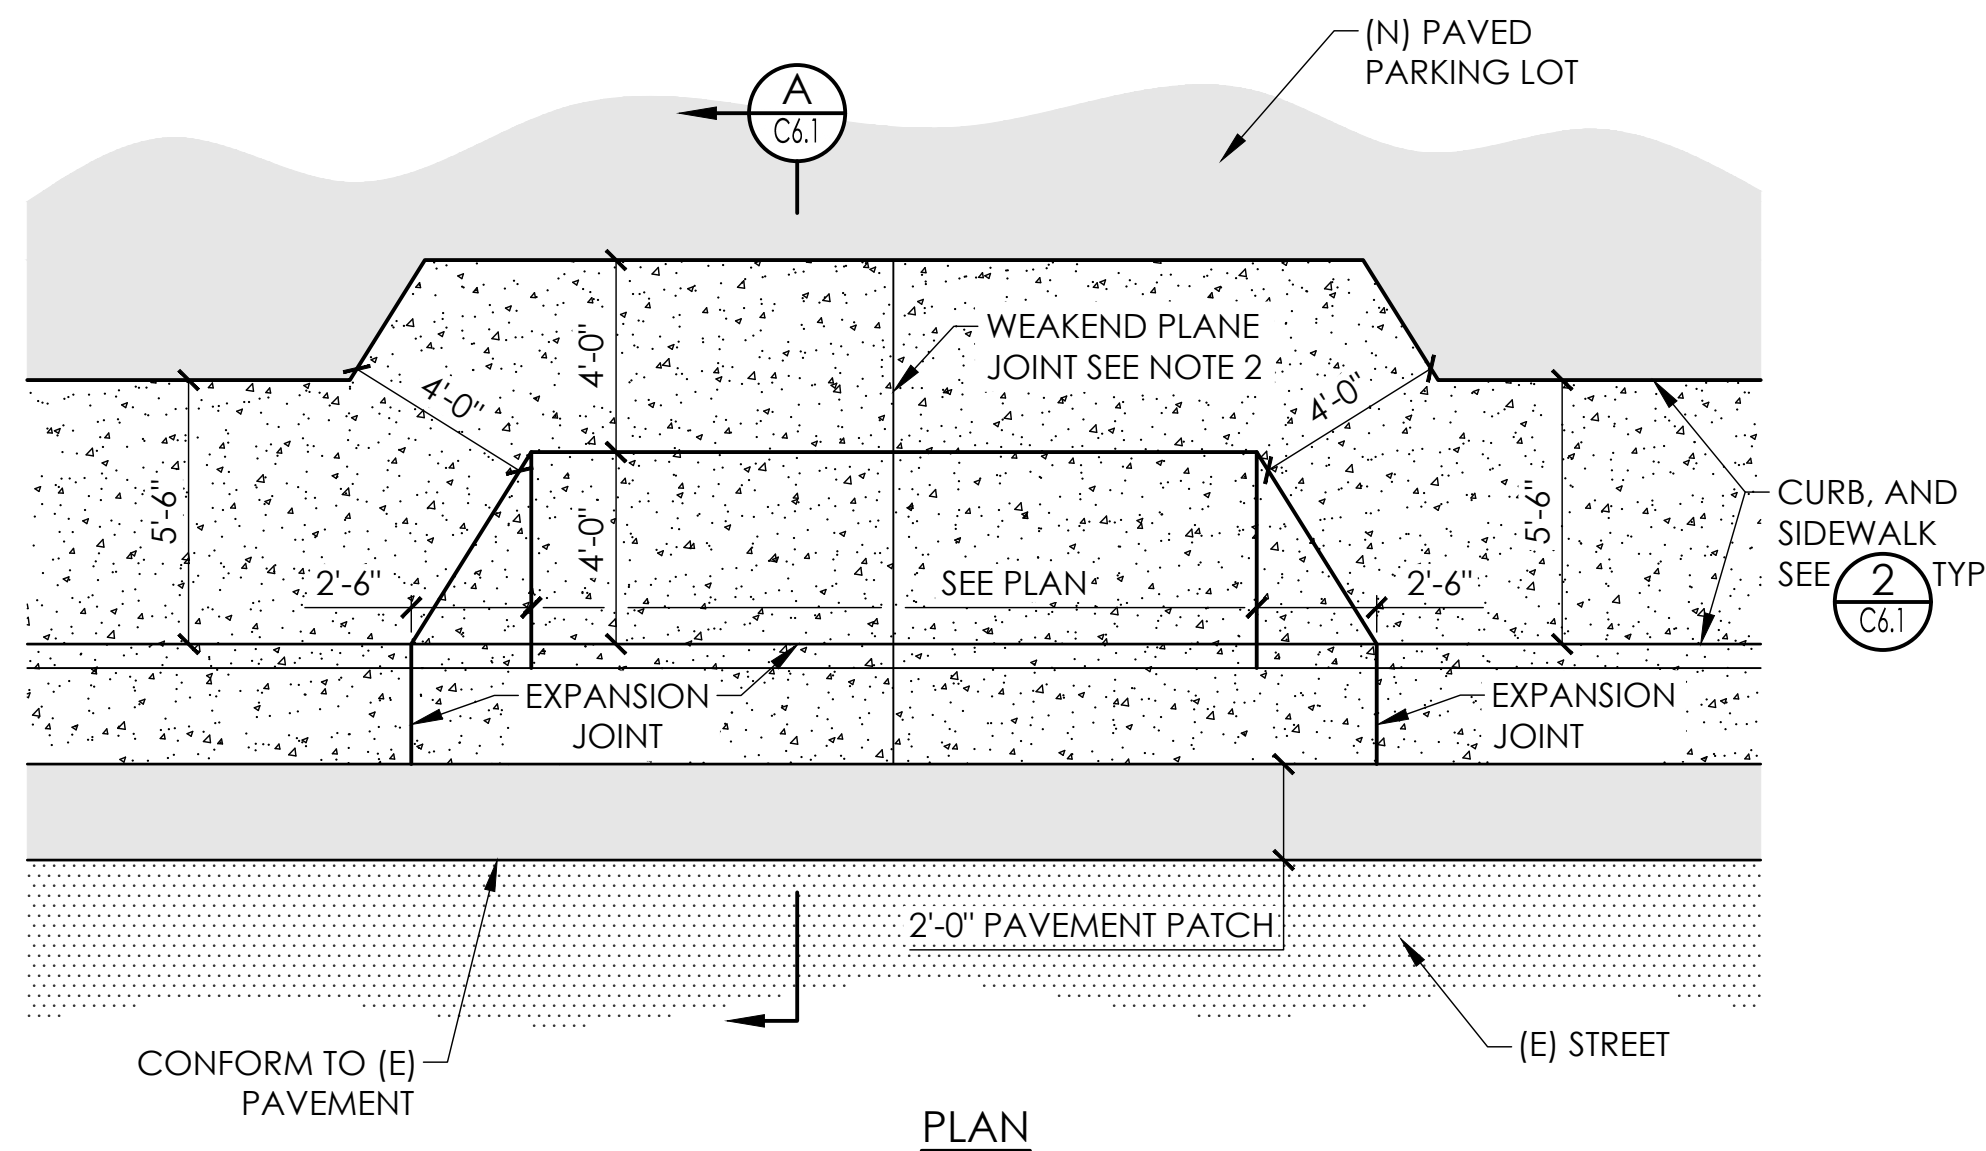

- NOTES:
1. ALL CONCRETE SHALL BE PER NOTE 2 ON SHEET C3.0.
 2. WEAKENED PLANE JOINTS SHALL BE TO A DEPTH OF 2-INCHES AND AT INTERVALS NOT TO EXCEED 12 FT O.C.
 3. CONTROL JOINTS SHALL BE EVENLY SPACED BETWEEN WEAKENED PLANE JOINTS AT 3 FT TO 5 FT INTERVALS.
 4. WEAKENED PLANE JOINTS AND SCORE LINES SHALL CORRESPOND WITH THOSE IN THE ADJACENT SIDEWALK UNLESS OTHERWISE SPECIFIED.
 5. THE AREA INCLUDED WITHIN THE SLOPE OF THE DRIVEWAY SHALL BE GIVEN A HEAVY BROOM FINISH.
 6. TOP OF LIP TO BE TROWELED STRAIGHT AND TRUE.

DRIVEWAY DETAIL
NTS 1
C6.1

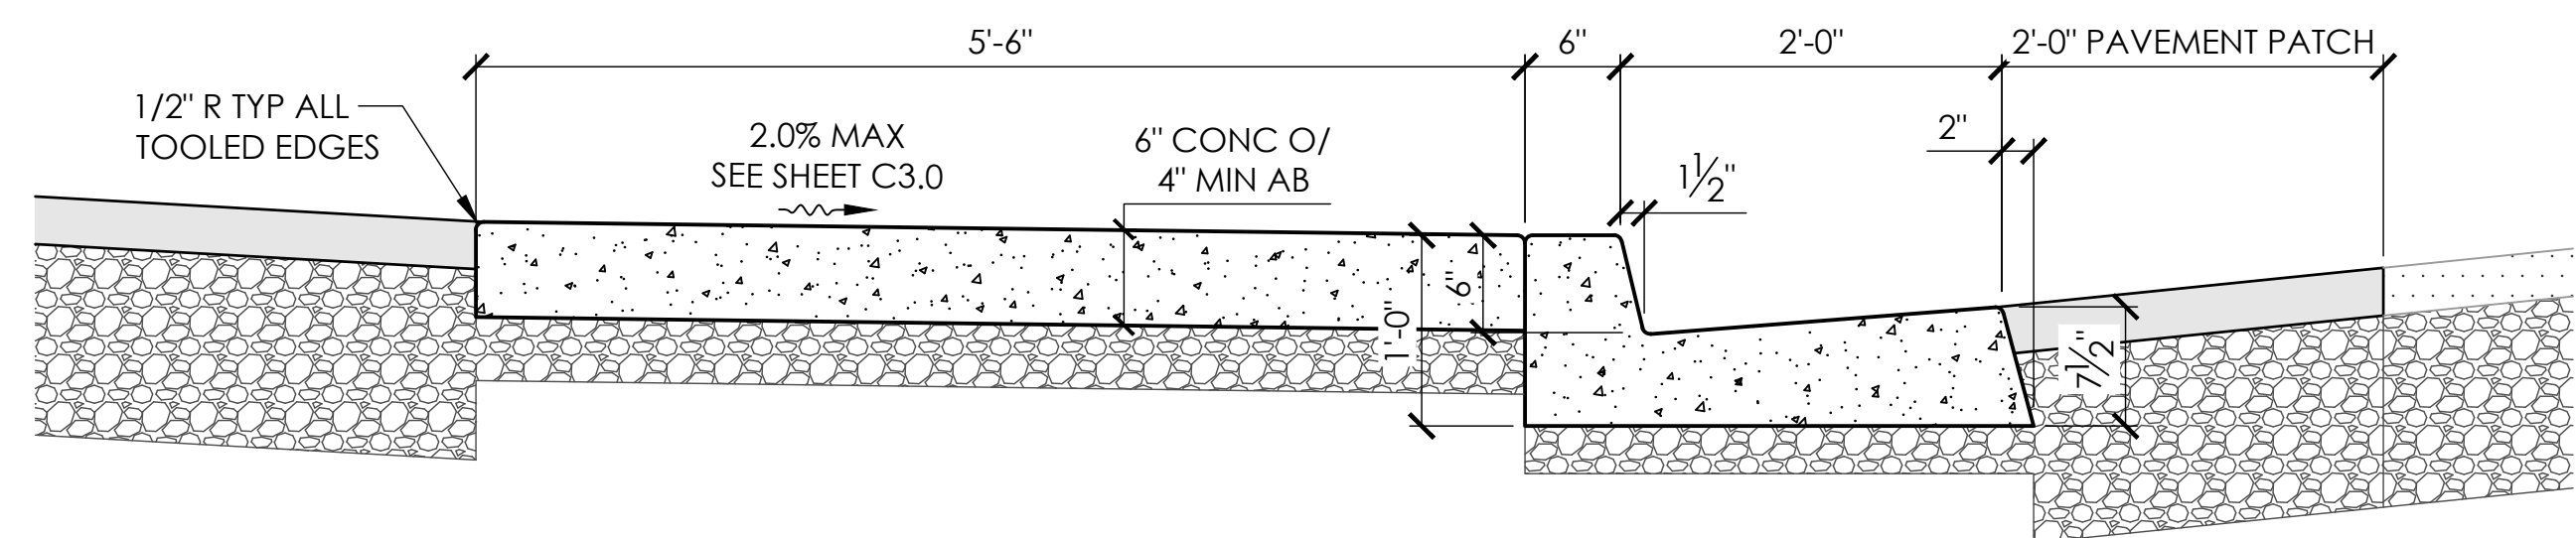

- NOTES:
1. ALL CONCRETE SHALL BE PER NOTE 2 ON SHEET C3.0.
 2. BROOMING IN CURBS SHALL BE PARALLEL TO THE DIRECTION OF FLOW. BROOMING IN SIDEWALKS SHALL BE PERPENDICULAR TO THE CURB.
 3. CONCRETE JOINTS SHALL BE PER THE FOLLOWING:
 - 3.a. CURB:
CONTROL JOINTS SHALL BE TO A DEPTH OF 2-INCHES AND AT INTERVALS NOT TO EXCEED 12 FT. O.C. THE TOP 3/4-INCH OF THE CONTROL JOINT SHALL BE FILLED WITH POLYURETHANE SEALANT (SIKAFLEX-1A OR EQUAL).
 - 3.b. SIDEWALKS:
PROVIDE EXPANSION JOINTS AT INTERVALS NOT TO EXCEED 12 FT O.C. CONTROL JOINTS SHALL BE EVENLY SPACED BETWEEN EXPANSION AT 3 FT TO 5 FT INTERVALS.
 4. SIDEWALKS MUST MAINTAIN A MINIMUM OF 4-FEET CLEAR WIDTH AT ALL TIMES.
 5. SIDEWALK GRADES SHALL NOT EXCEED 5-PERCENT EXCEPT TO MATCH THE GRADE OF THE ADJACENT STREET OR ROADWAY.

CONC CURB GUTTER AND SIDEWALK DETAIL
NTS 2
C6.1


PERMIT SET

BAR IS ONE INCH ON ORIGINAL DRAWING
0" — 1"
IF NOT ONE INCH ON THIS SHEET, ADJUST SCALES ACCORDINGLY.

REVISIONS		
NO	DATE	DESCRIPTION


PACE ENGINEERING

DES: RT CKD: TJS/Wg JOB NO. DRN: RT DATE: 9/10/24 0470.22


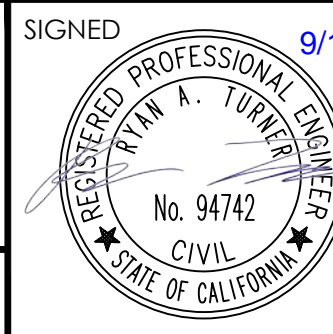


SISKIYOU COUNTY GOVERNMENT CENTER
PARKING LOT IMPROVEMENTS
STANDARD DETAILS

SHEET
C6.1
PG 10 OF 17

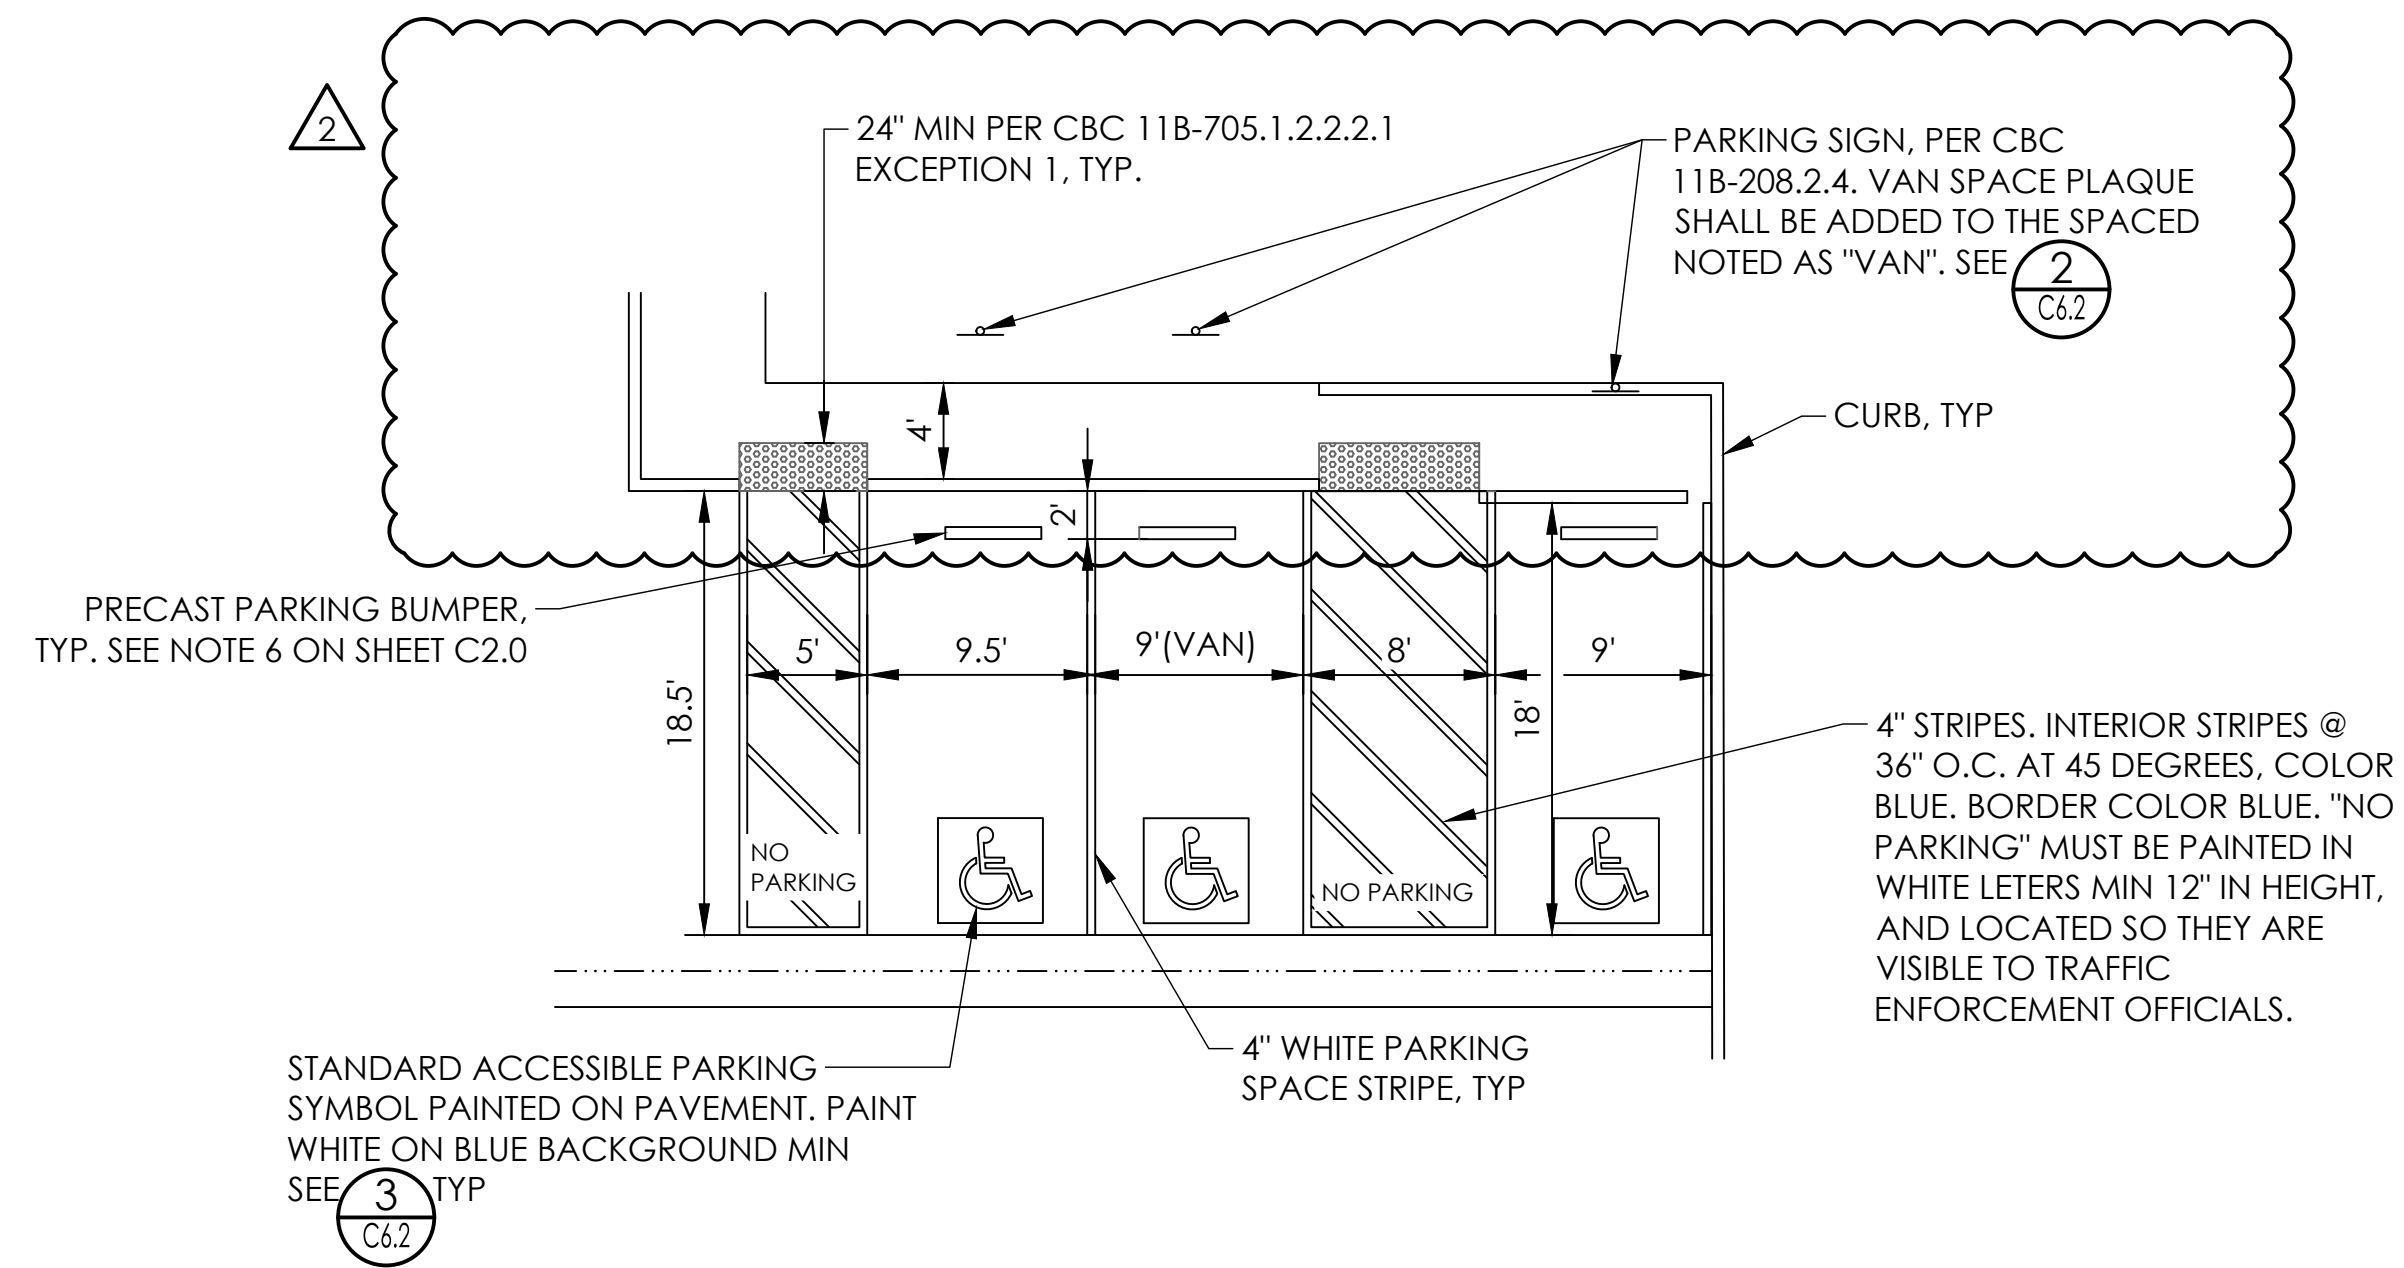


- NOTES:
- 2% MAXIMUM SLOPE AT ACCESSIBLE PARKING SPACES AND ACCESS AISLES IN ANY DIRECTION.
 - ALL ACCESSIBLE RAMPS AND ACCESS AISLES SHALL MEET ALL CODES AND ADAAG REGULATIONS.

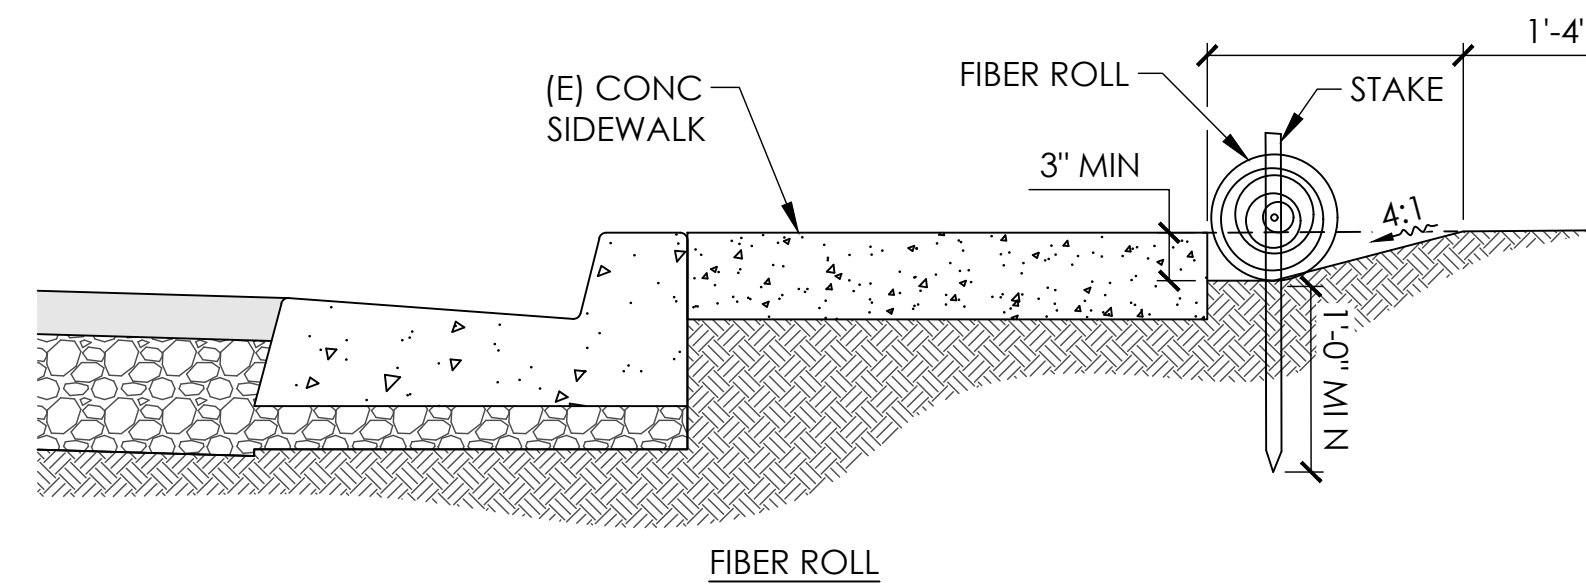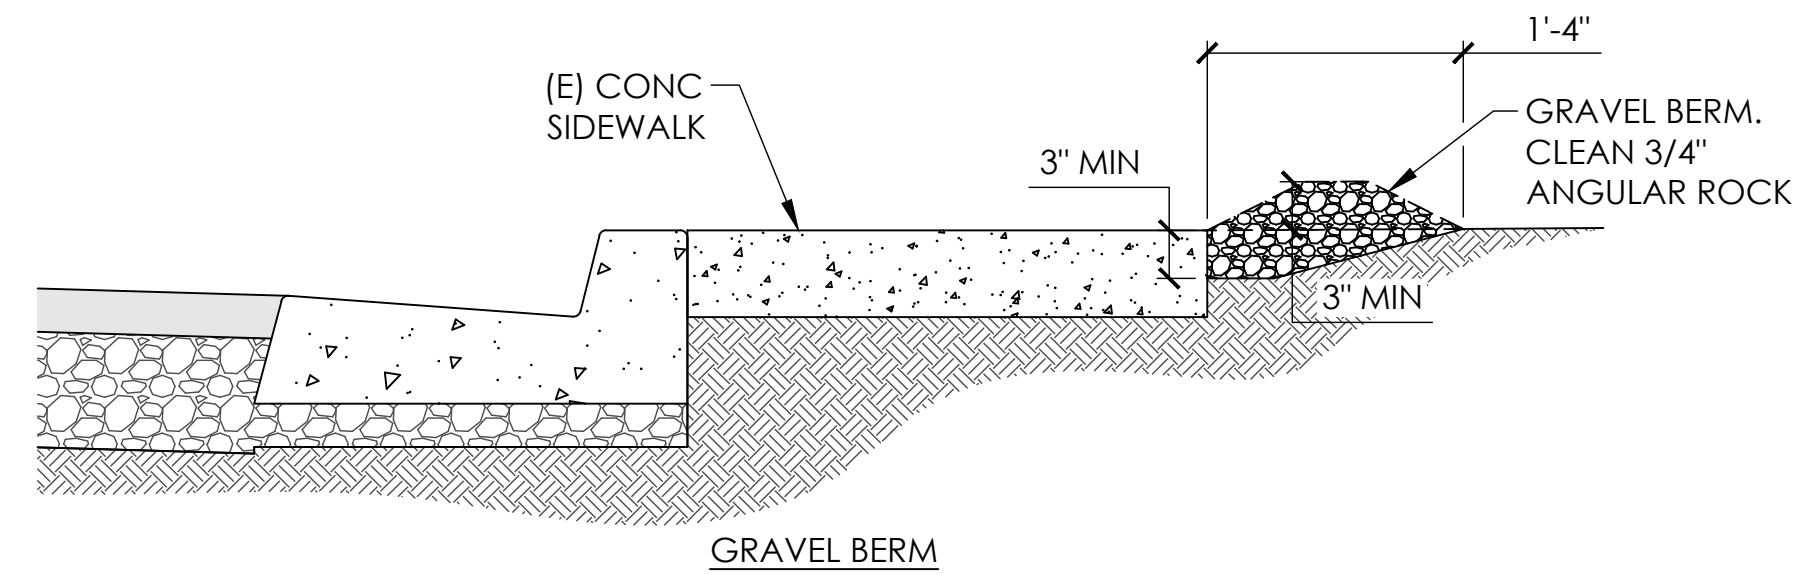


- NOTES:
- CONTRACTOR SHALL USE THE FIBER ROLL UNLESS NOTED OTHERWISE ON SHEET C4.0.
 - FIBER ROLLS SHALL BE A PREMANUFACTURED ROLL FILLED WITH SEEDLESS STRAW, OR APPROVED EQUAL, AND BE COVERED WITH A BIODEGRADABLE NETTING.

PERIMETER SEDIMENT BARRIER (5) NTS C6.2

ACCESSIBLE PARKING DETAIL (1) NTS C6.2

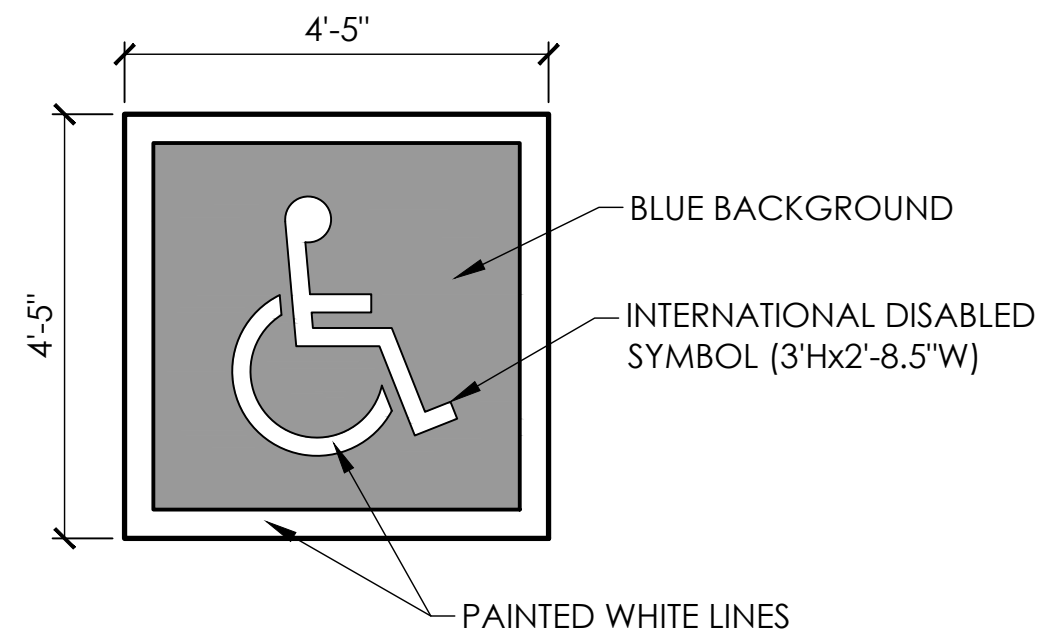


ACCESSIBLE PARKING DETAIL (3) NTS C6.2

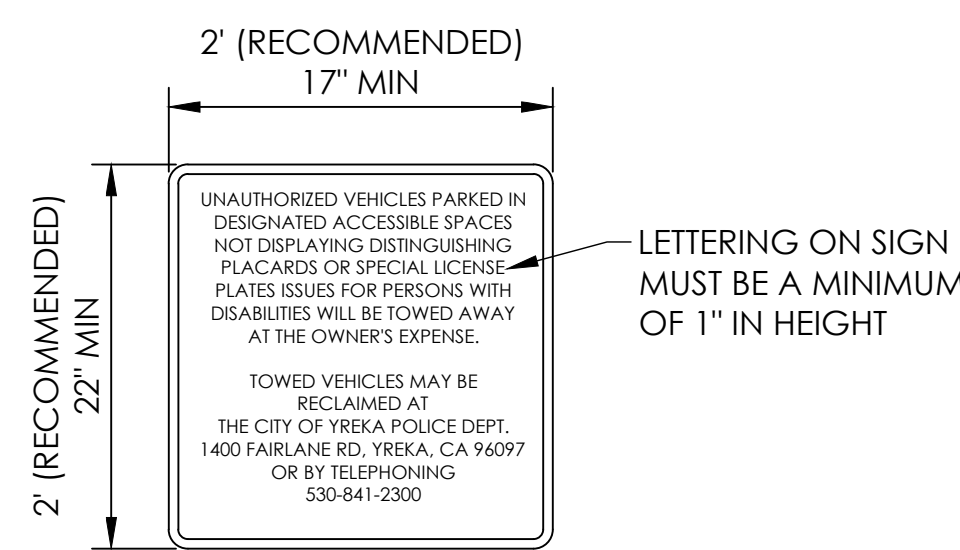


- NOTES:
- REFER TO CALTRANS STD PLAN A90 & CBC 11B-502.8.


ACCESSIBLE PARKING DETAIL (2) NTS C6.2

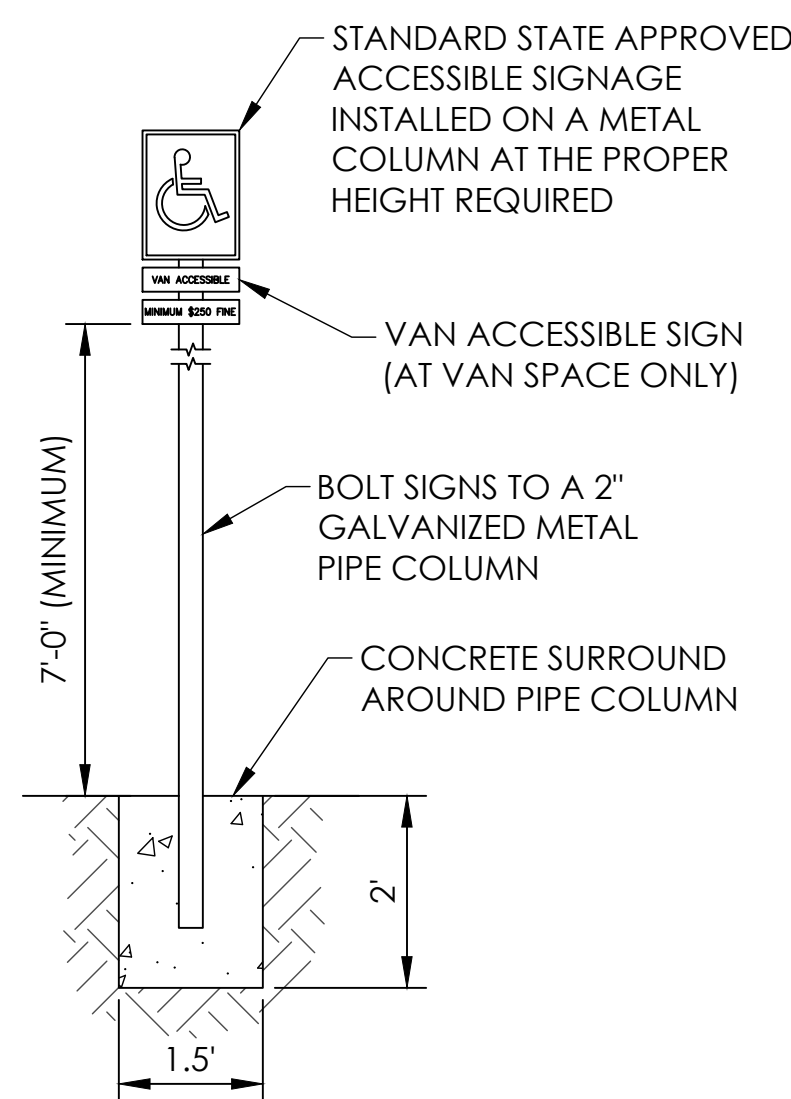



ACCESSIBLE PARKING DETAIL (4) NTS C6.2

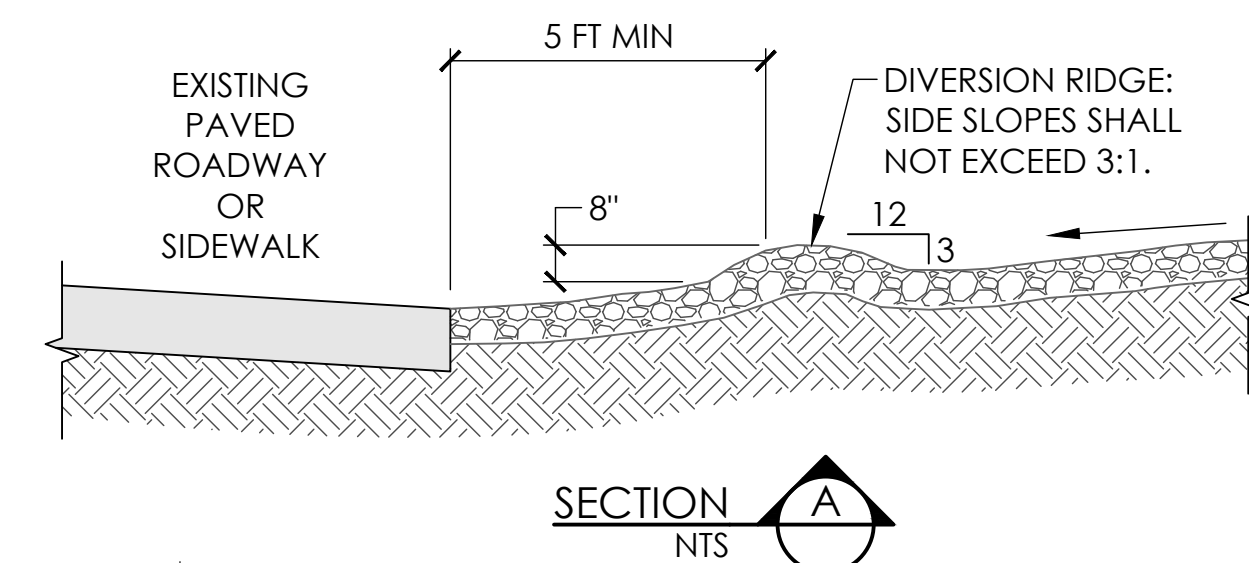

SECTION (A) NTS

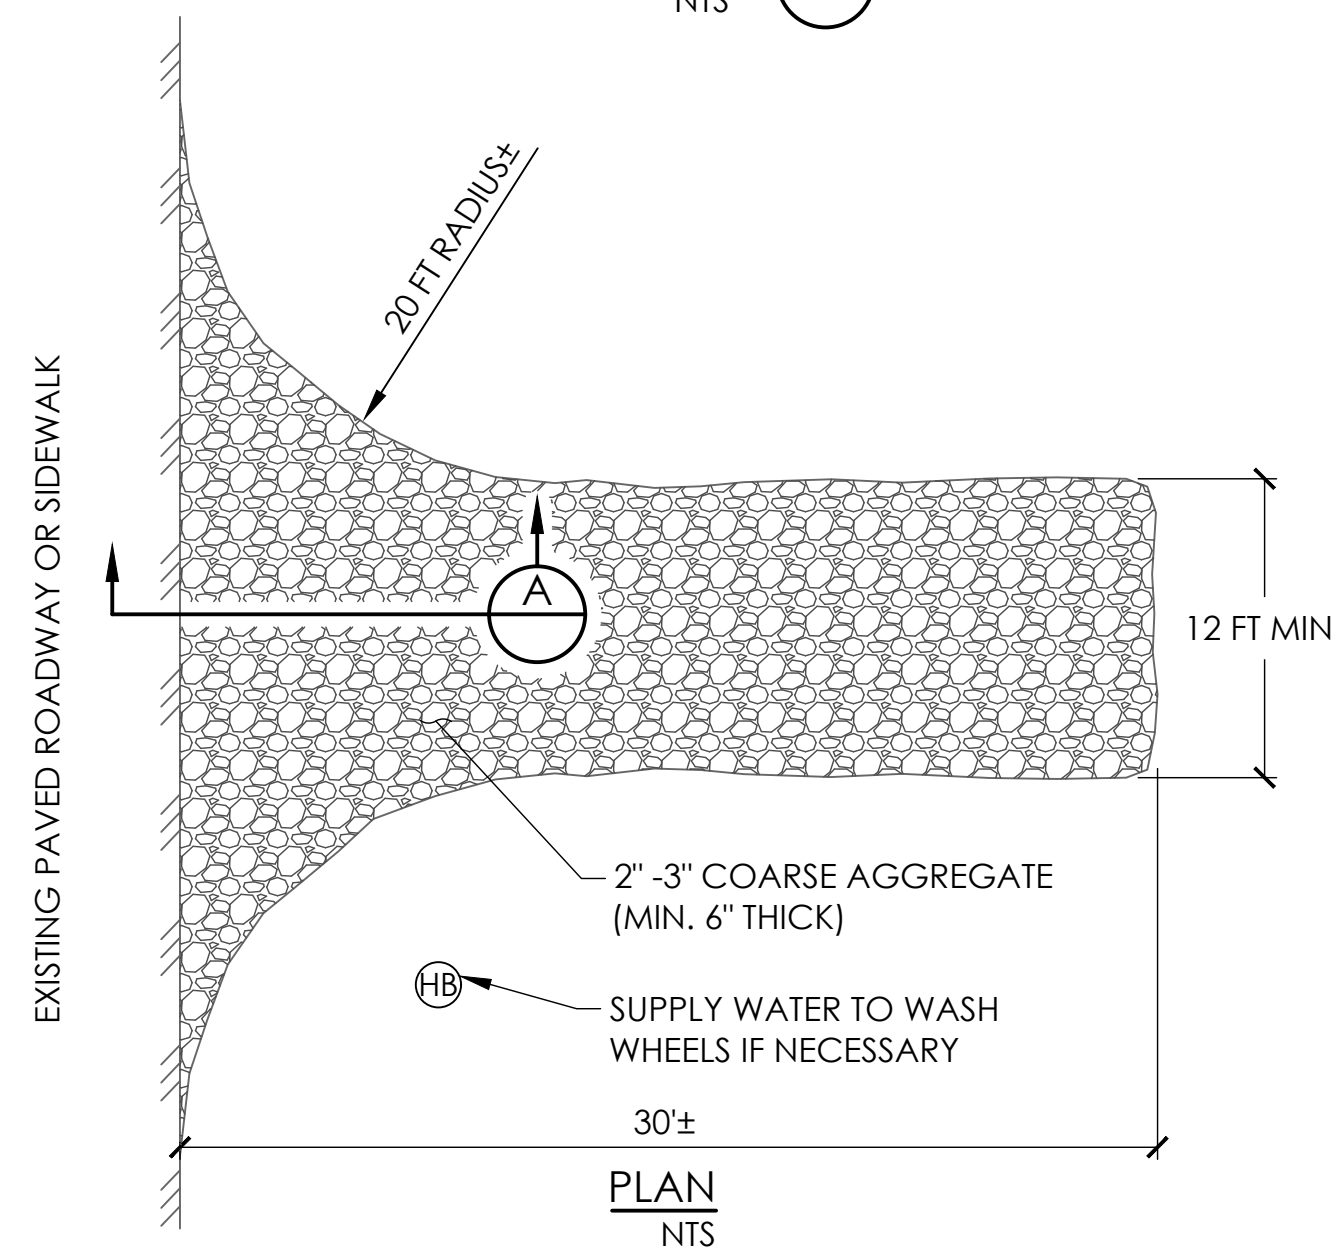

TEMPORARY GRAVEL CONSTRUCTION EXIT (6) NTS C6.2

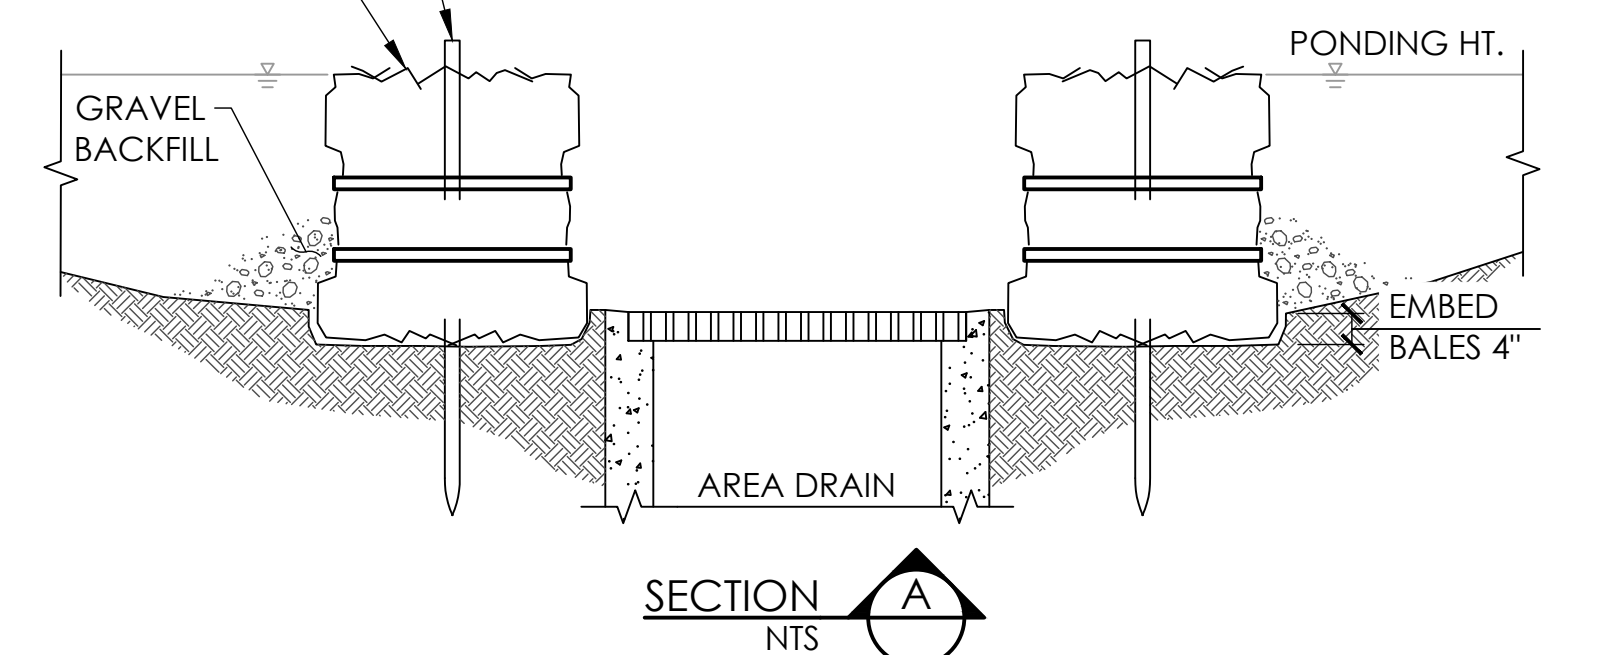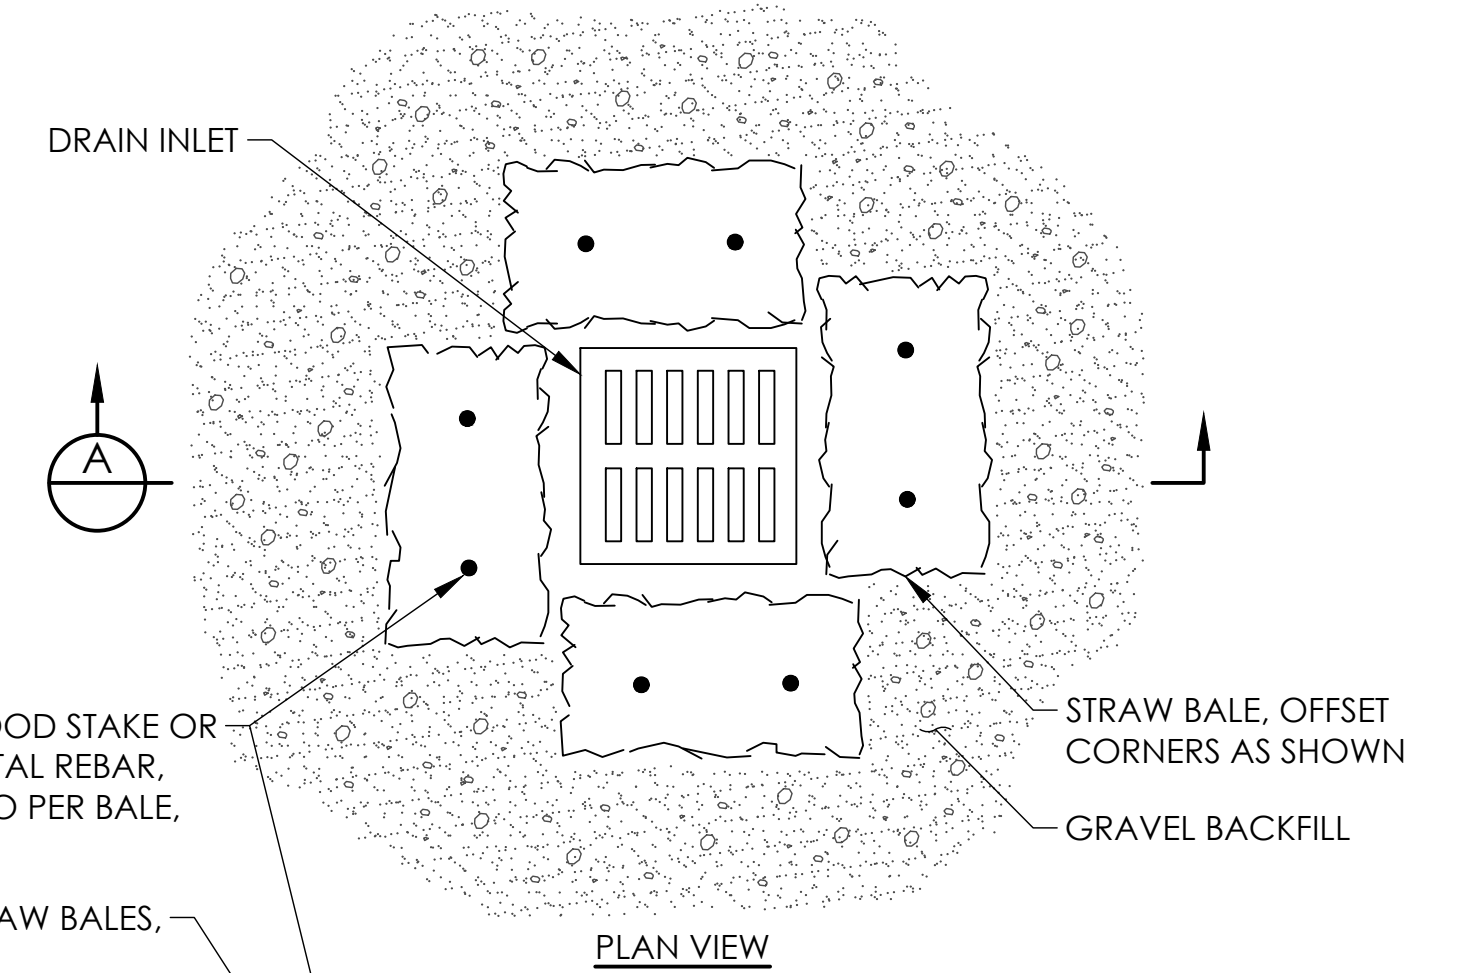

- NOTES:
- TO BE USED FOR SMALL, NEARLY LEVEL DRAINAGE AREAS (LESS THAN 5%) AND AREA IMMEDIATELY ADJACENT TO INLET SHOULD BE RELATIVELY FLAT (LESS THAN 1%)

STRAW BALE / GRAVEL DROP INLET SEDIMENT BARRIER (7) NTS C6.2

PERMIT SET

BAR IS ONE INCH ON ORIGINAL DRAWING
0" 1"
IF NOT ONE INCH ON THIS SHEET, ADJUST SCALES ACCORDINGLY.

REVISIONS		
NO	DATE	DESCRIPTION
2	9-18-24	PLAN CHECK REVISIONS




DES RT CKD TJ/SWg JOB NO.
DRN RT DATE 9/18/24 0470.22




SISKIYOU COUNTY GOVERNMENT CENTER
PARKING LOT IMPROVEMENTS
ADA AND EROSION CONTROL DETAILS

SHEET
C6.2
PG 11 OF 17

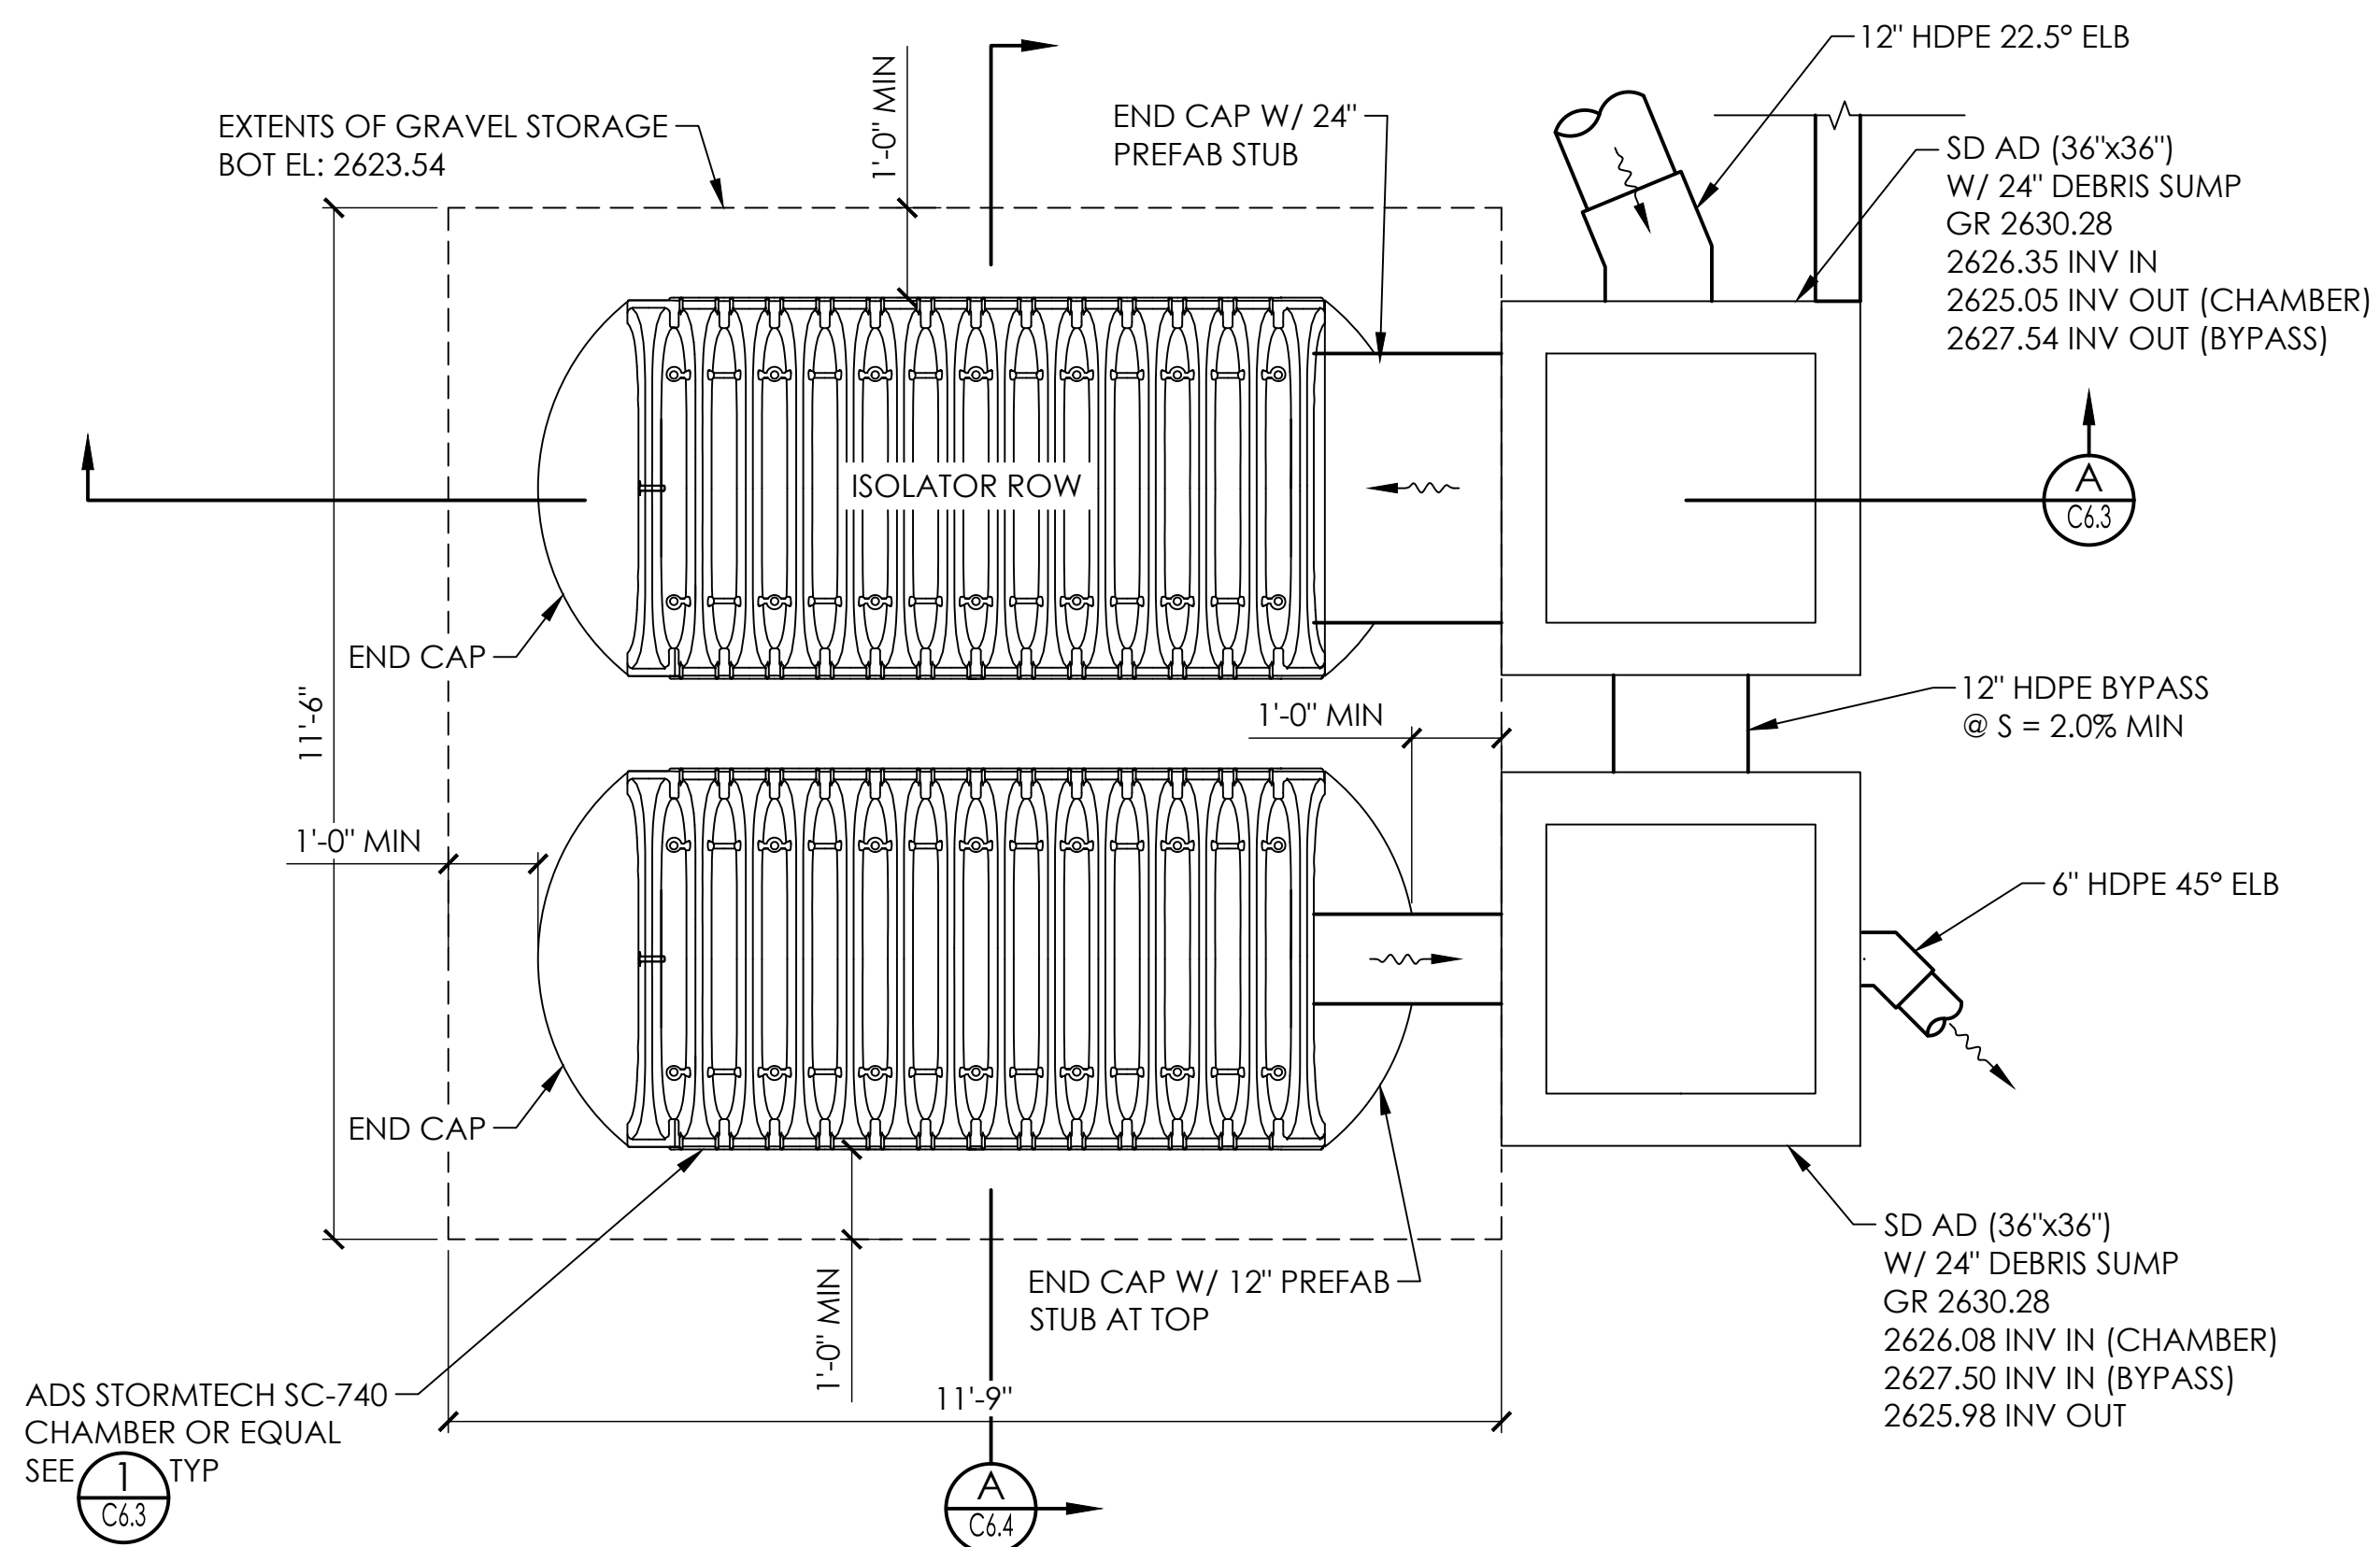

INFILTRATION GALLERY DETAIL (1)
NTS C6.3

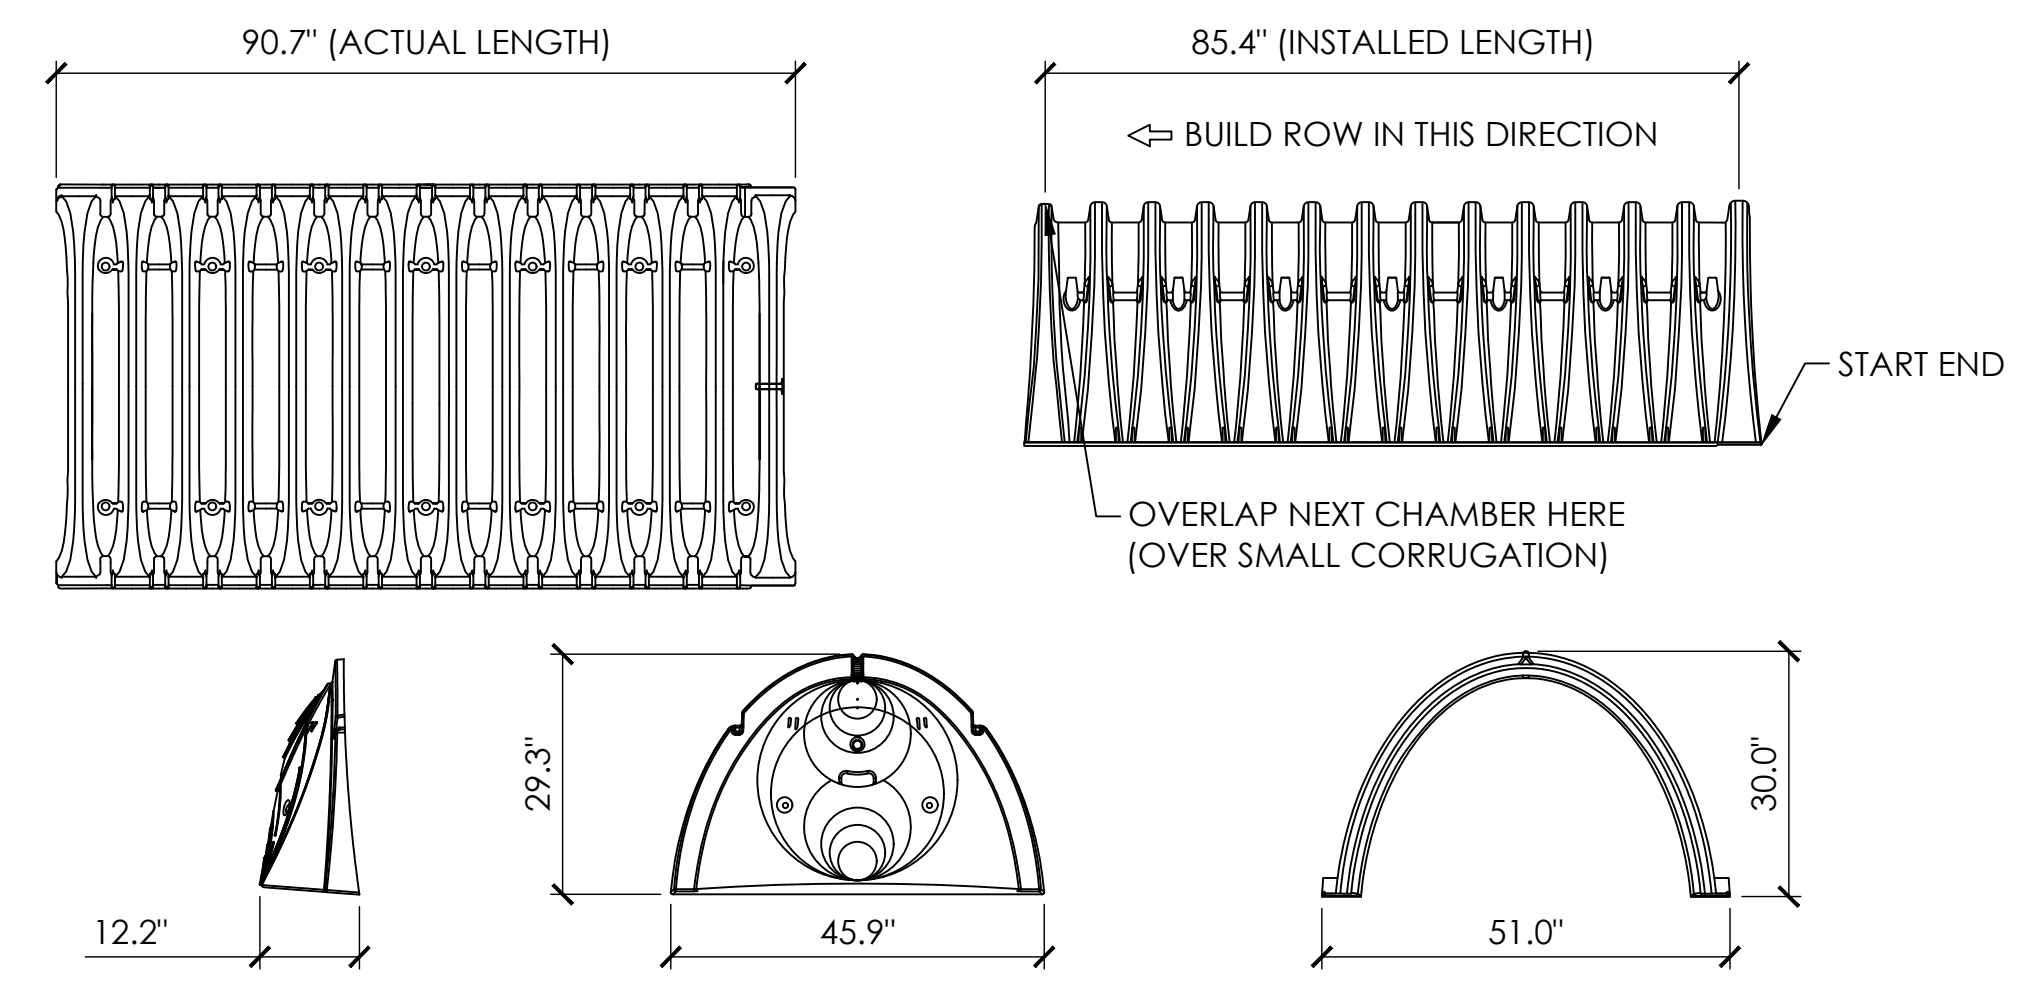

NOMINAL CHAMBER SPECIFICATIONS:


SIZE (W X H X INSTALLED LENGTH)	51.0" X 30.0" X 85.4"	(1295 mm X 762 mm X 2169 mm)
CHAMBER STORAGE	45.9 CUBIC FEET	(1.30 m³)
MINIMUM INSTALLED STORAGE*	74.9 CUBIC FEET	(2.12 m³)
WEIGHT	75.0 lbs.	(33.6 kg)

NOMINAL END CAP SPECIFICATIONS:

SIZE (W X H X INSTALLED LENGTH)	45.9" X 29.3" X 9.6"	(1166 mm X 744 mm X 244 mm)
END CAP STORAGE	2.6 CUBIC FEET	(0.07 m³)
MINIMUM INSTALLED STORAGE**	13.5 CUBIC FEET	(0.38 m³)
WEIGHT	11.7 lbs.	(5.3 kg)


* ASSUMES 6" (152 mm) STONE ABOVE, BELOW, AND BETWEEN CHAMBERS
 ** ASSUMES 6" (152 mm) STONE ABOVE AND BELOW END CAPS, 6" (152 mm) BETWEEN ROWS, 12" (305 mm) BEYOND END CAPS

STORMTECH SC-740 CHAMBER DETAIL AND SPECIFICATION (2)
NTS C6.3

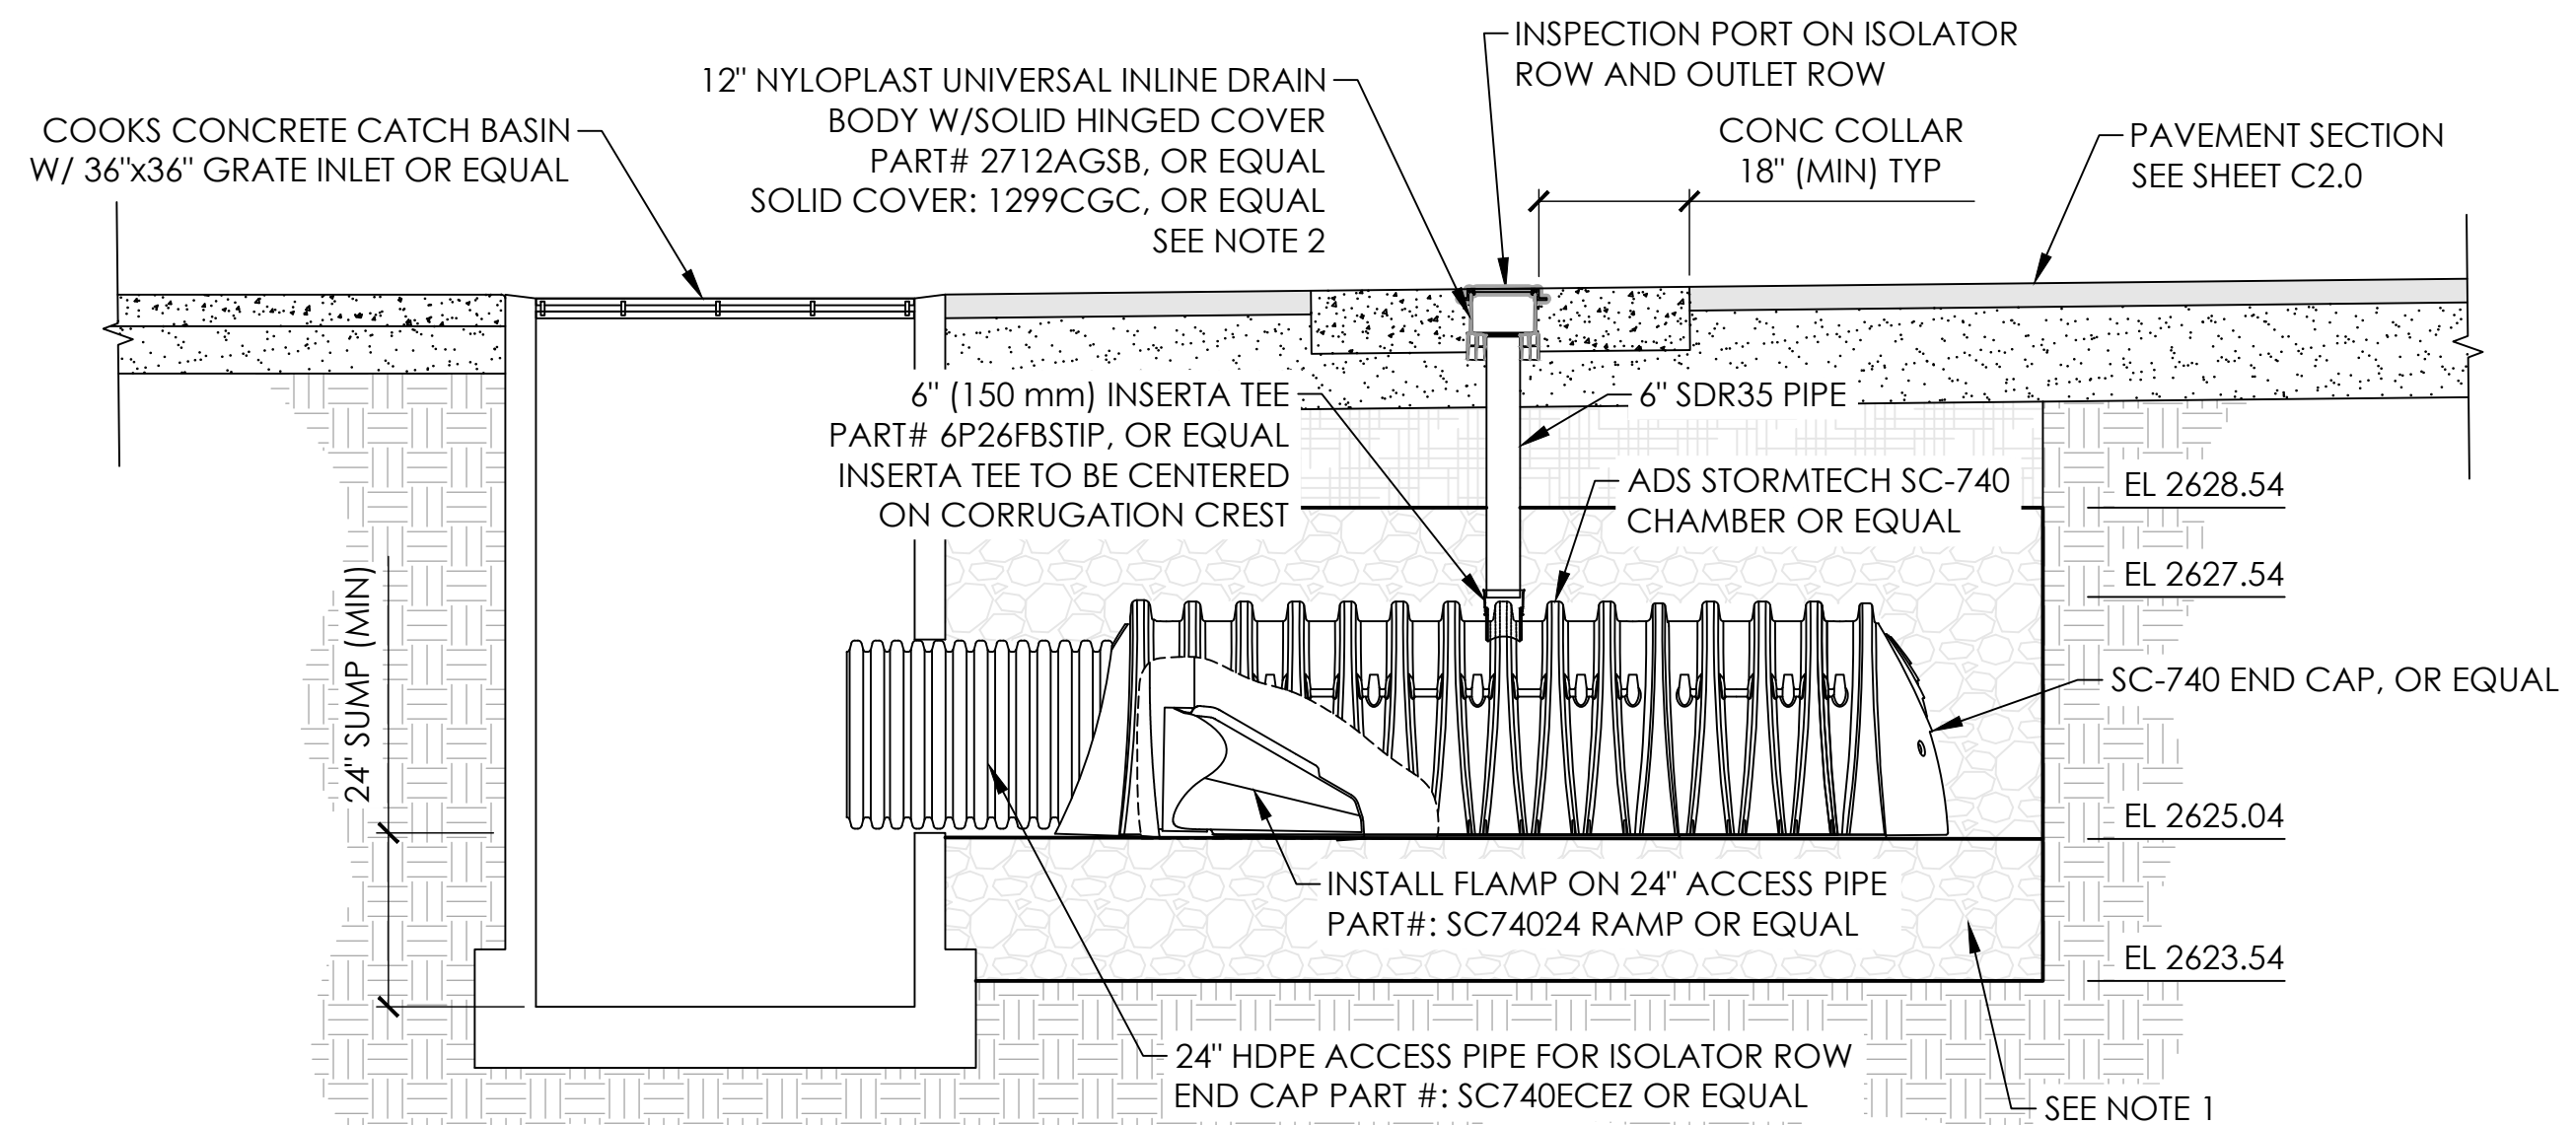

- NOTES:
- REFER TO SHEET C6.4 FOR BACKFILL REQUIREMENTS AND SPECIFICATIONS
 - PART# 2712AG6IPKIT CAN BE USED TO ORDER ALL NECESSARY COMPONENTS FOR A SOLID LID INSPECTION PORT INSTALLATION

SECTION A-A
NTS C6.3

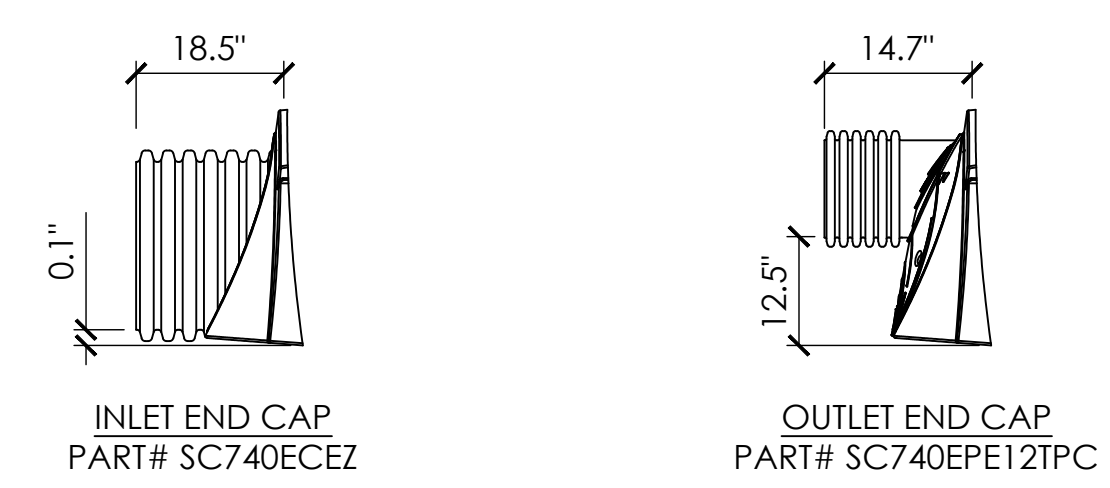

STORMTECH END CAP DETAILS (2)
NTS C6.3

- NOTES:
- ALL STUBS, EXCEPT FOR THE SC740ECEZ ARE PLACED AT BOTTOM OF END CAP SUCH THAT THE OUTSIDE DIAMETER OF THE STUB IS FLUSH WITH THE BOTTOM OF THE END CAP. FOR ADDITIONAL INFORMATION CONTACT STORMTECH AT 1-888-892-2694.
 - FOR THE SC740ECEZ THE 24" (600 mm) STUB LIES BELOW THE BOTTOM OF THE END CAP APPROXIMATELY 1.75" (44 mm). BACKFILL MATERIAL SHOULD BE REMOVED FROM BELOW THE N-12 STUB SO THAT THE FITTING SITS LEVEL.
 - ALL DIMENSIONS ARE NOMINAL




PERMIT SET

BAR IS ONE INCH ON ORIGINAL DRAWING

0" 1"

IF NOT ONE INCH ON THIS SHEET, ADJUST SCALES ACCORDINGLY.

REVISIONS		DESCRIPTION
NO	DATE	

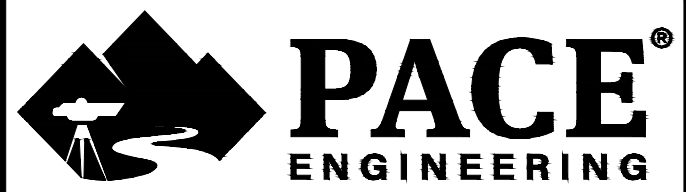

DES	RT	CKD	TJ/SWg	JOB NO.
DRN	RT	DATE	9/10/24	0470.22




SISKIYOU COUNTY GOVERNMENT CENTER
PARKING LOT IMPROVEMENTS

INFILTRATION GALLERY DETAILS

SHEET
C6.3
PG 12 OF 17

Plot Date: September 10, 2024 - 9:05 am, Login Name: rturner
 File Name: M:\land projects\047022 government center ada parking\01 CAD\05 CIVIL\PSWdwg Layout: Gallery Plan

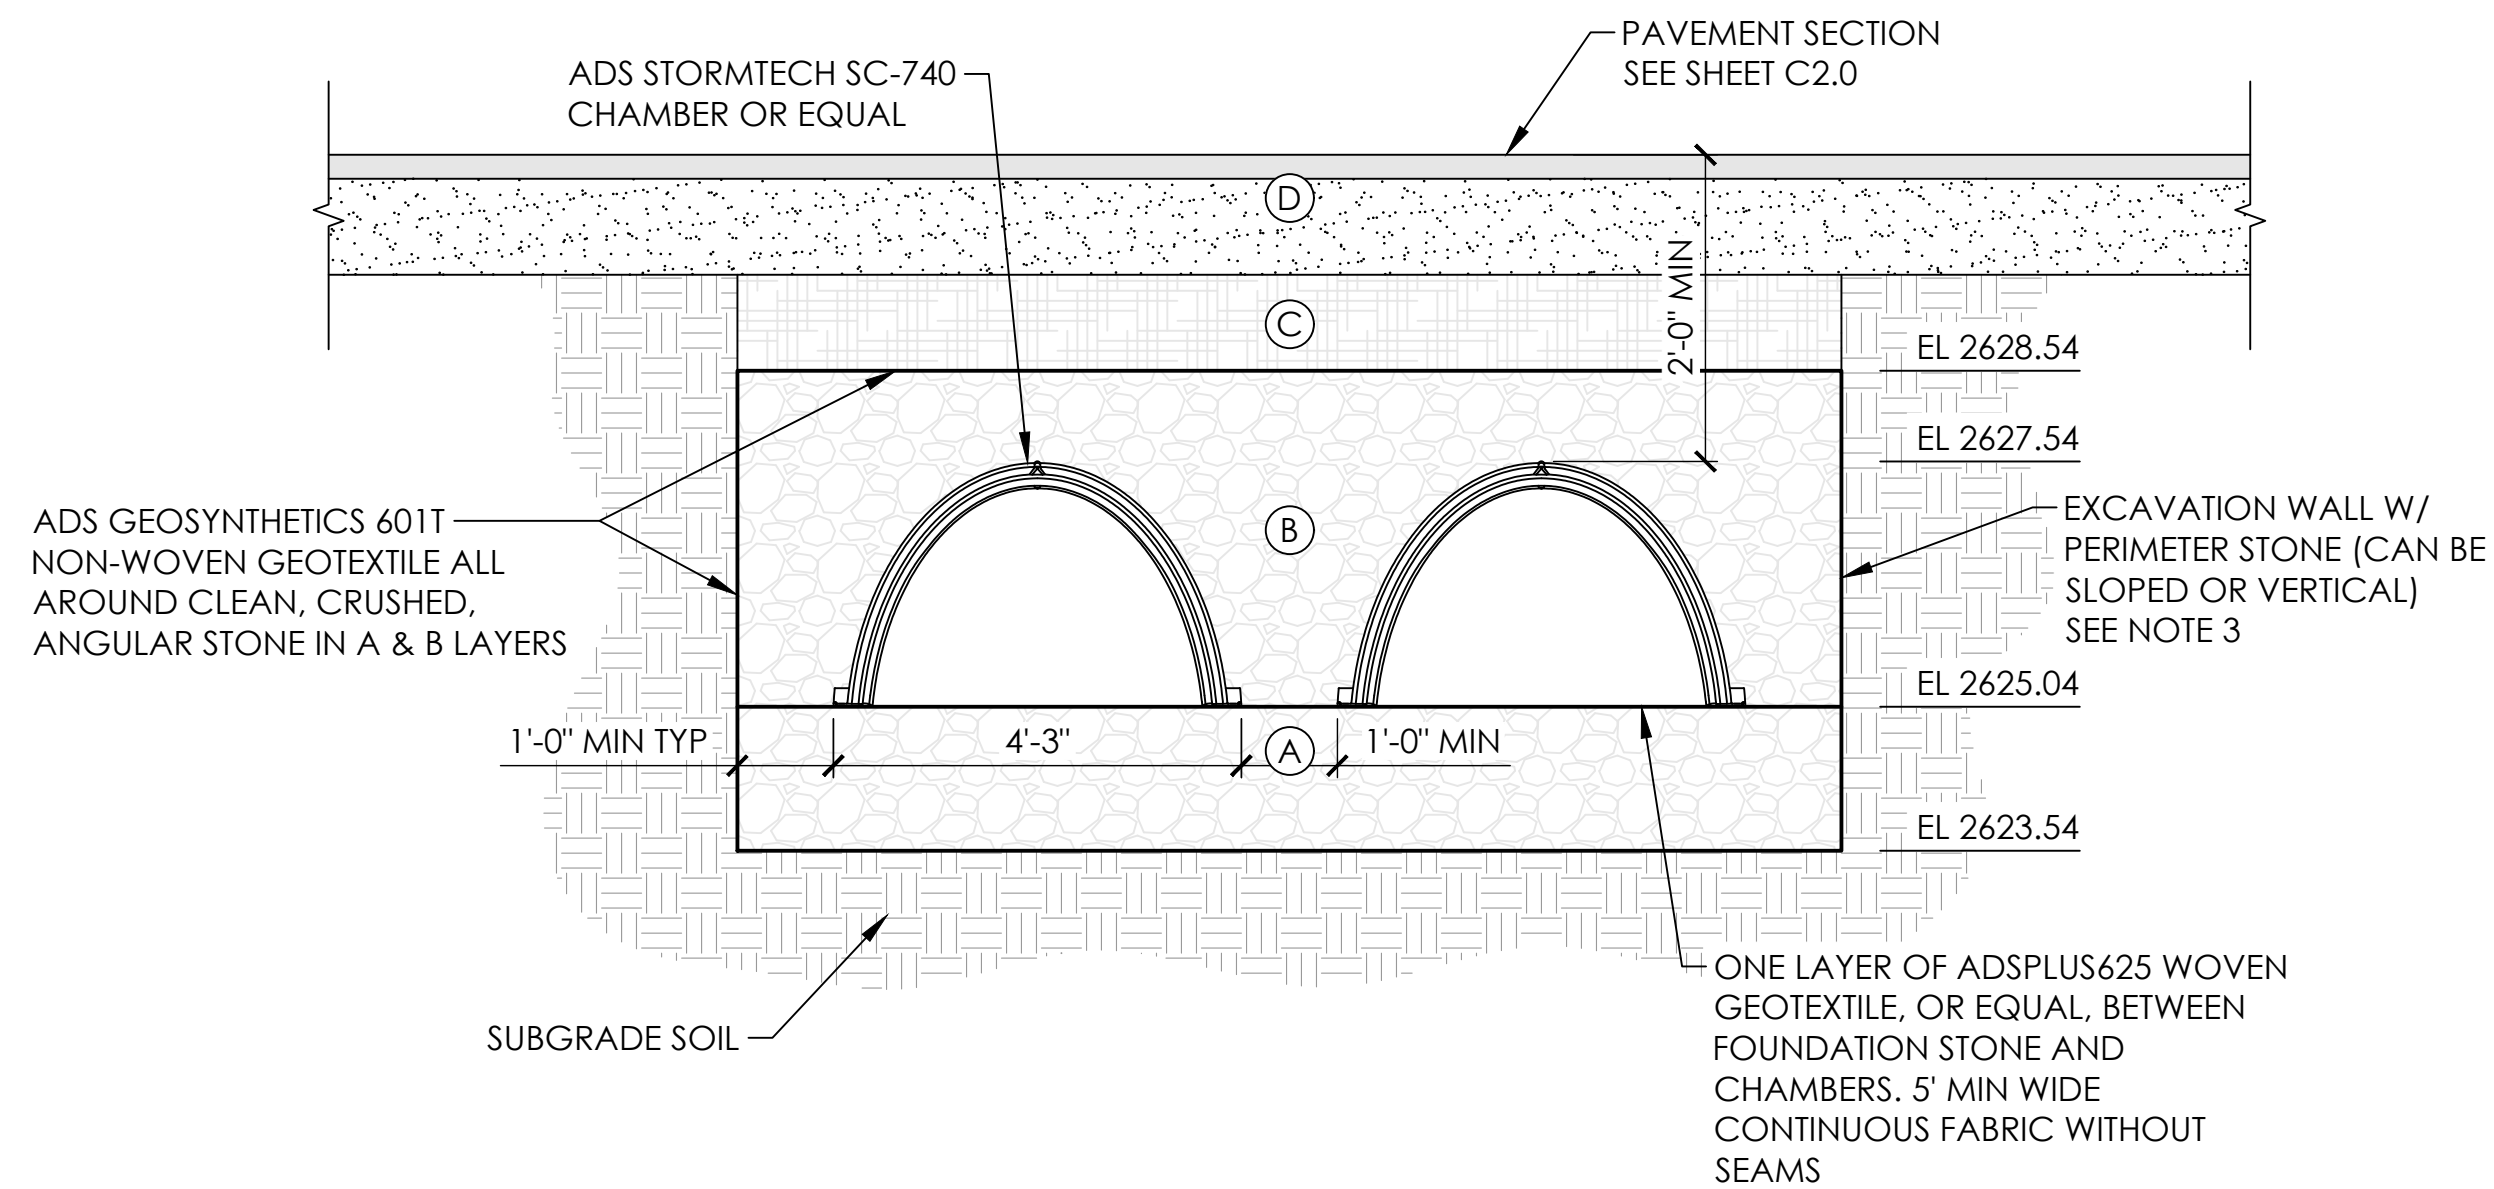

NOTES

1. CHAMBERS SHALL MEET THE REQUIREMENTS OF ASTM F2418, "STANDARD SPECIFICATION FOR POLYPROPYLENE (PP) CORRUGATED WALL STORMWATER COLLECTION CHAMBERS".
2. CHAMBERS SHALL BE DESIGNED IN ACCORDANCE WITH ASTM F2787 "STANDARD PRACTICE FOR STRUCTURAL DESIGN OF THERMOPLASTIC CORRUGATED WALL STORMWATER COLLECTION CHAMBERS".
3. PERIMETER STONE MUST BE EXTENDED HORIZONTALLY TO THE EXCAVATION WALL FOR BOTH VERTICAL AND SLOPED EXCAVATION WALLS.
4. REQUIREMENTS FOR HANDLING AND INSTALLATION:
 - TO MAINTAIN THE WIDTH OF CHAMBERS DURING SHIPPING AND HANDLING, CHAMBERS SHALL HAVE INTEGRAL, INTERLOCKING STACKING LUGS.
 - TO ENSURE A SECURE JOINT DURING INSTALLATION AND BACKFILL, THE HEIGHT OF THE CHAMBER JOINT SHALL NOT BE LESS THAN 2".
 - TO ENSURE THE INTEGRITY OF THE ARCH SHAPE DURING INSTALLATION, a) THE ARCH STIFFNESS CONSTANT SHALL BE GREATER THAN OR EQUAL TO 550 LBS/FT/%. THE ASC IS DEFINED IN SECTION 6.2.8 OF ASTM F2418. AND b) TO RESIST CHAMBER DEFORMATION DURING INSTALLATION AT ELEVATED TEMPERATURES (ABOVE 73° F / 23° C), CHAMBERS SHALL BE PRODUCED FROM REFLECTIVE GOLD OR YELLOW COLORS.

ACCEPTABLE FILL MATERIALS: STORMTECH SC-740 CHAMBER SYSTEMS

MATERIAL LOCATION	DESCRIPTION	AASHTO MATERIAL CLASSIFICATIONS	COMPACTION / DENSITY REQUIREMENT
D FINAL SURFACING: FILL MATERIAL FOR LAYER 'D' STARTS FROM THE TOP OF THE 'C' LAYER TO THE FINISH SURFACE.	AS SPECIFIED ON SHEET C2.0.	N/A	AS SPECIFIED ON SHEETS C2.0 AND C3.0.
C INITIAL FILL: FILL MATERIAL FOR LAYER 'C' STARTS FROM THE TOP OF THE EMBEDMENT STONE ('B' LAYER) TO PAVEMENT SUBBASE ('D' LAYER).	GRANULAR WELL-GRADED SOIL/AGGREGATE MIXTURES, <35% FINES OR PROCESSED AGGREGATE. CLASS 2 AGGREGATE BASE IS ALSO ACCEPTABLE	AASHTO M145 ¹ A-1, A-2-4, A-3 AASHTO M43 ¹ 3, 357, 4, 467, 5, 56, 57, 6, 67, 68, 7, 78, 8, 89, 9, 10	BEGIN COMPACTIONS AFTER 12" OF MATERIAL OVER THE CHAMBERS IS REACHED. COMPACT ADDITIONAL LAYERS IN 6" MAX LIFTS TO A MIN. 95% PROCTOR DENSITY FOR WELL GRADED MATERIAL AND 95% RELATIVE DENSITY FOR PROCESSED AGGREGATE MATERIALS. ROLLER GROSS VEHICLE WEIGHT NOT TO EXCEED 12,000 lbs. DYNAMIC FORCE NOT TO EXCEED 20,000 lbs.
B EMBEDMENT STONE: FILL SURROUNDING THE CHAMBERS FROM THE FOUNDATION STONE ('A' LAYER) TO THE 'C' LAYER ABOVE.	CLEAN, CRUSHED, ANGULAR STONE	AASHTO M43 ¹ 3, 357, 4, 467, 5, 56, 57	NO COMPACTION REQUIRED.
A FOUNDATION STONE: FILL BELOW CHAMBERS FROM THE SUBGRADE UP TO THE FOOT (BOTTOM) OF THE CHAMBER.	CLEAN, CRUSHED, ANGULAR STONE	AASHTO M43 ¹ 3, 357, 4, 467, 5, 56, 57	PLATE COMPACT OR ROLL TO ACHIEVE A FLAT SURFACE. ^{2,3}

NOTE:


1. THE LISTED AASHTO DESIGNATIONS ARE FOR GRADATIONS ONLY. THE STONE MUST ALSO BE CLEAN, CRUSHED, AND ANGULAR.
2. STORMTECH COMPACTION REQUIREMENTS ARE MET FOR 'A' LOCATION MATERIALS WHEN PLACED AND COMPACTED IN 6" (MAX) LIFTS USING TWO FULL COVERAGES WITH A VIBRATORY COMPACTOR.
3. WHERE INFILTRATION SURFACES MAY BE COMPROMISED BY COMPACTION, FOR STANDARD DESIGN LOAD CONDITIONS, A FLAT SURFACE MAY BE ACHIEVED BY RAKING OR DRAGGING WITHOUT COMPACTION EQUIPMENT. FOR SPECIAL LOAD DESIGNS, CONTACT STORMTECH FOR COMPACTION REQUIREMENTS.
4. LAYER "D" SHALL BE THE PAVEMENT SECTION PER SHEET C2.0.



PERMIT SET

BAR IS ONE INCH ON ORIGINAL DRAWING
0" — 1"
IF NOT ONE INCH ON THIS SHEET, ADJUST SCALES ACCORDINGLY.

REVISIONS		
NO	DATE	DESCRIPTION

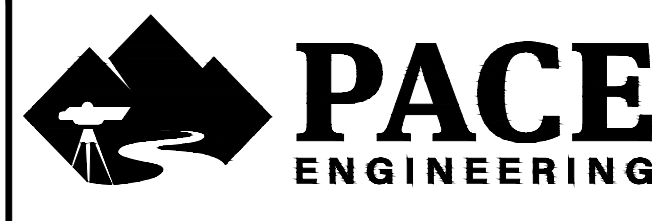

DES: RT CKD: TJSWg JOB NO. 0470.22
DRN: RT DATE: 9/10/24



SISKIYOU COUNTY GOVERNMENT CENTER
PARKING LOT IMPROVEMENTS
INFILTRATION GALLERY DETAILS


SHEET
C6.4
PG 13 OF 17

RUNOFF CALCULATION INPUT PARAMETERS		
PARAMETER	PRE-CONSTRUCTION	POST-CONSTRUCTION
IMPERVIOUS AREA	0.22ac (9,600sf)	0.22ac (9,600sf)
IMPERVIOUS CURVE NUMBER	98	98
PERVIOUS AREA	0	0
PERVIOUS CURVE NUMBER	N/A	N/A
TOTAL AREA	0.22ac (9,600sf)	0.22ac (9,600sf)
COMBINED CURVE NUMBER	98	98
FLOW LENGTH	150	150
FLOW SLOPE	1.0%	1.0%
TIME OF CONCENTRATION	3.33	3.33
STORM TYPE	IA	IA


CALCULATED PEAK FLOWS			
PARAMETER	2-YEAR	10-YEAR	100-YEAR
PRE-CONSTRUCTION	0.10cfs (45gpm)	0.16cfs (72gpm)	0.23cfs (104gpm)
POST-CONSTRUCTION	0.10cfs (45gpm)	0.16cfs (72gpm)	0.23cfs (104gpm)

NOTES


1. THIS DRAINAGE ANALYSIS WAS PERFORMED USING THE SOIL CONSERVATION SERVICE (SCS) METHOD IN AUTODESK HYDRAFLOW SOFTWARE. THE INPUT PARAMETERS FOR THE PRE-CONSTRUCTION AND POST-CONSTRUCTION BASIN CAN BE FOUND IN THE TABLE. NO ADDITIONAL RUNOFF WILL BE CREATED BY THE PROPOSED IMPROVEMENTS.
2. TIME OF CONCENTRATION WAS DETERMINED BASED ON THE LAG METHOD WHERE $TC=1.67(LAG\ TIME)$.
3. THE CALCULATIONS ON SHEET C5.0 IS CALCULATED TO INFILTRATE THE 2-YEAR TO 10-YEAR RAIN EVENT. THE SUMP PUMP IS DESIGNED TO PUMP THE DIFFERENCE BETWEEN THE 2-YEAR AND THE 100-YEAR RAIN EVENT. (60gpm±)

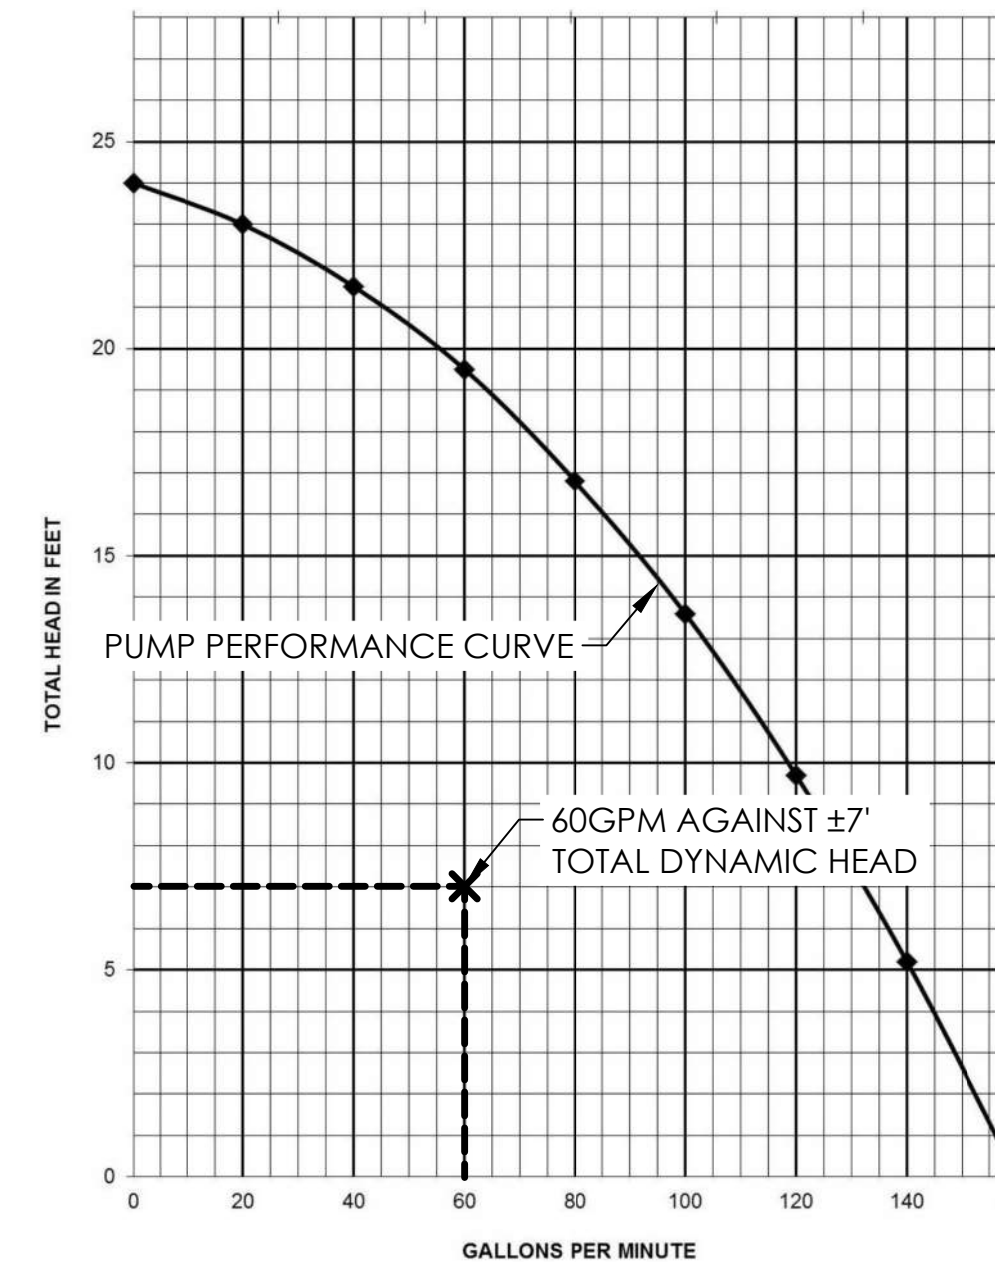


LE51M PUMP CURVE TABLE

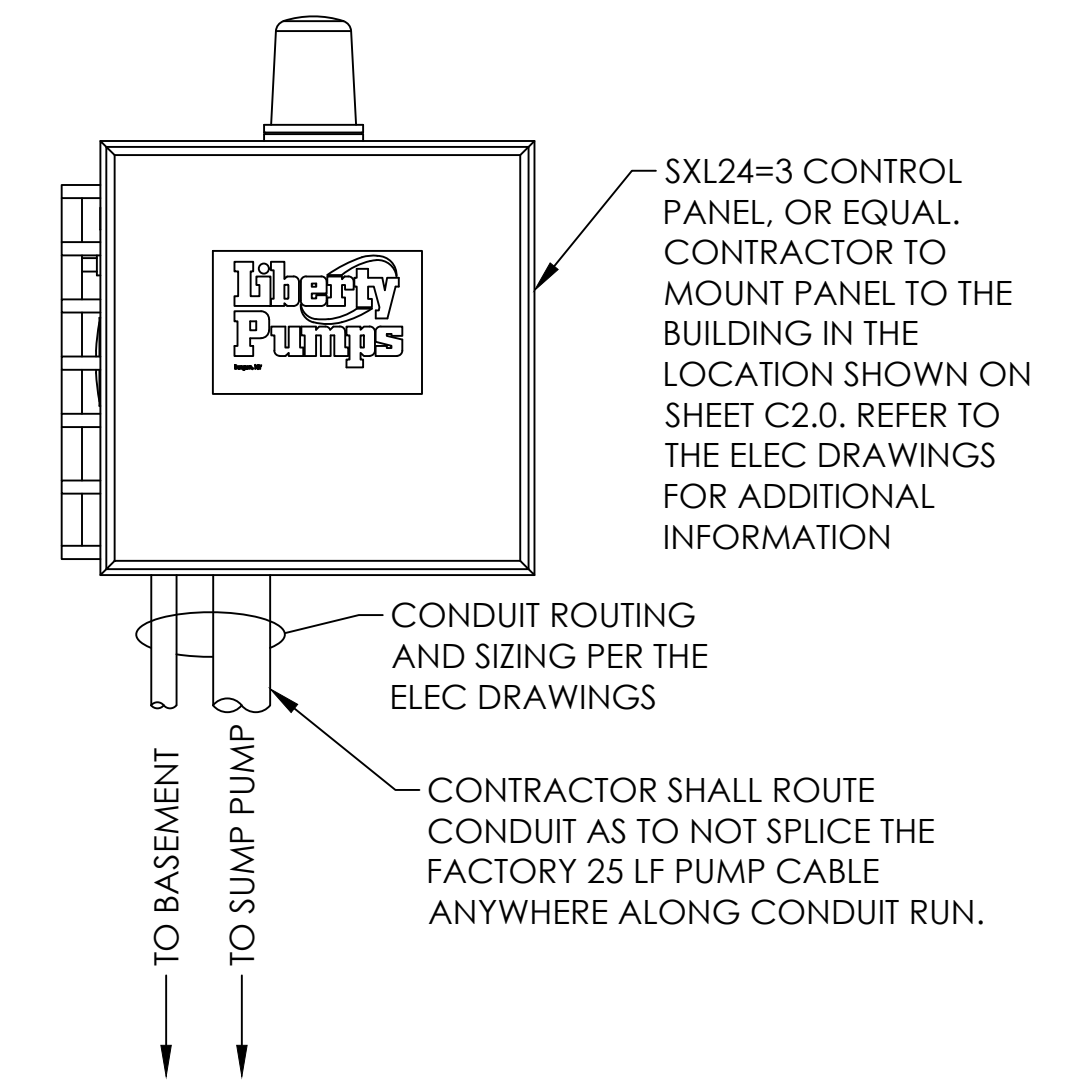

SUMP PUMP DETAIL 2 NTS C6.5

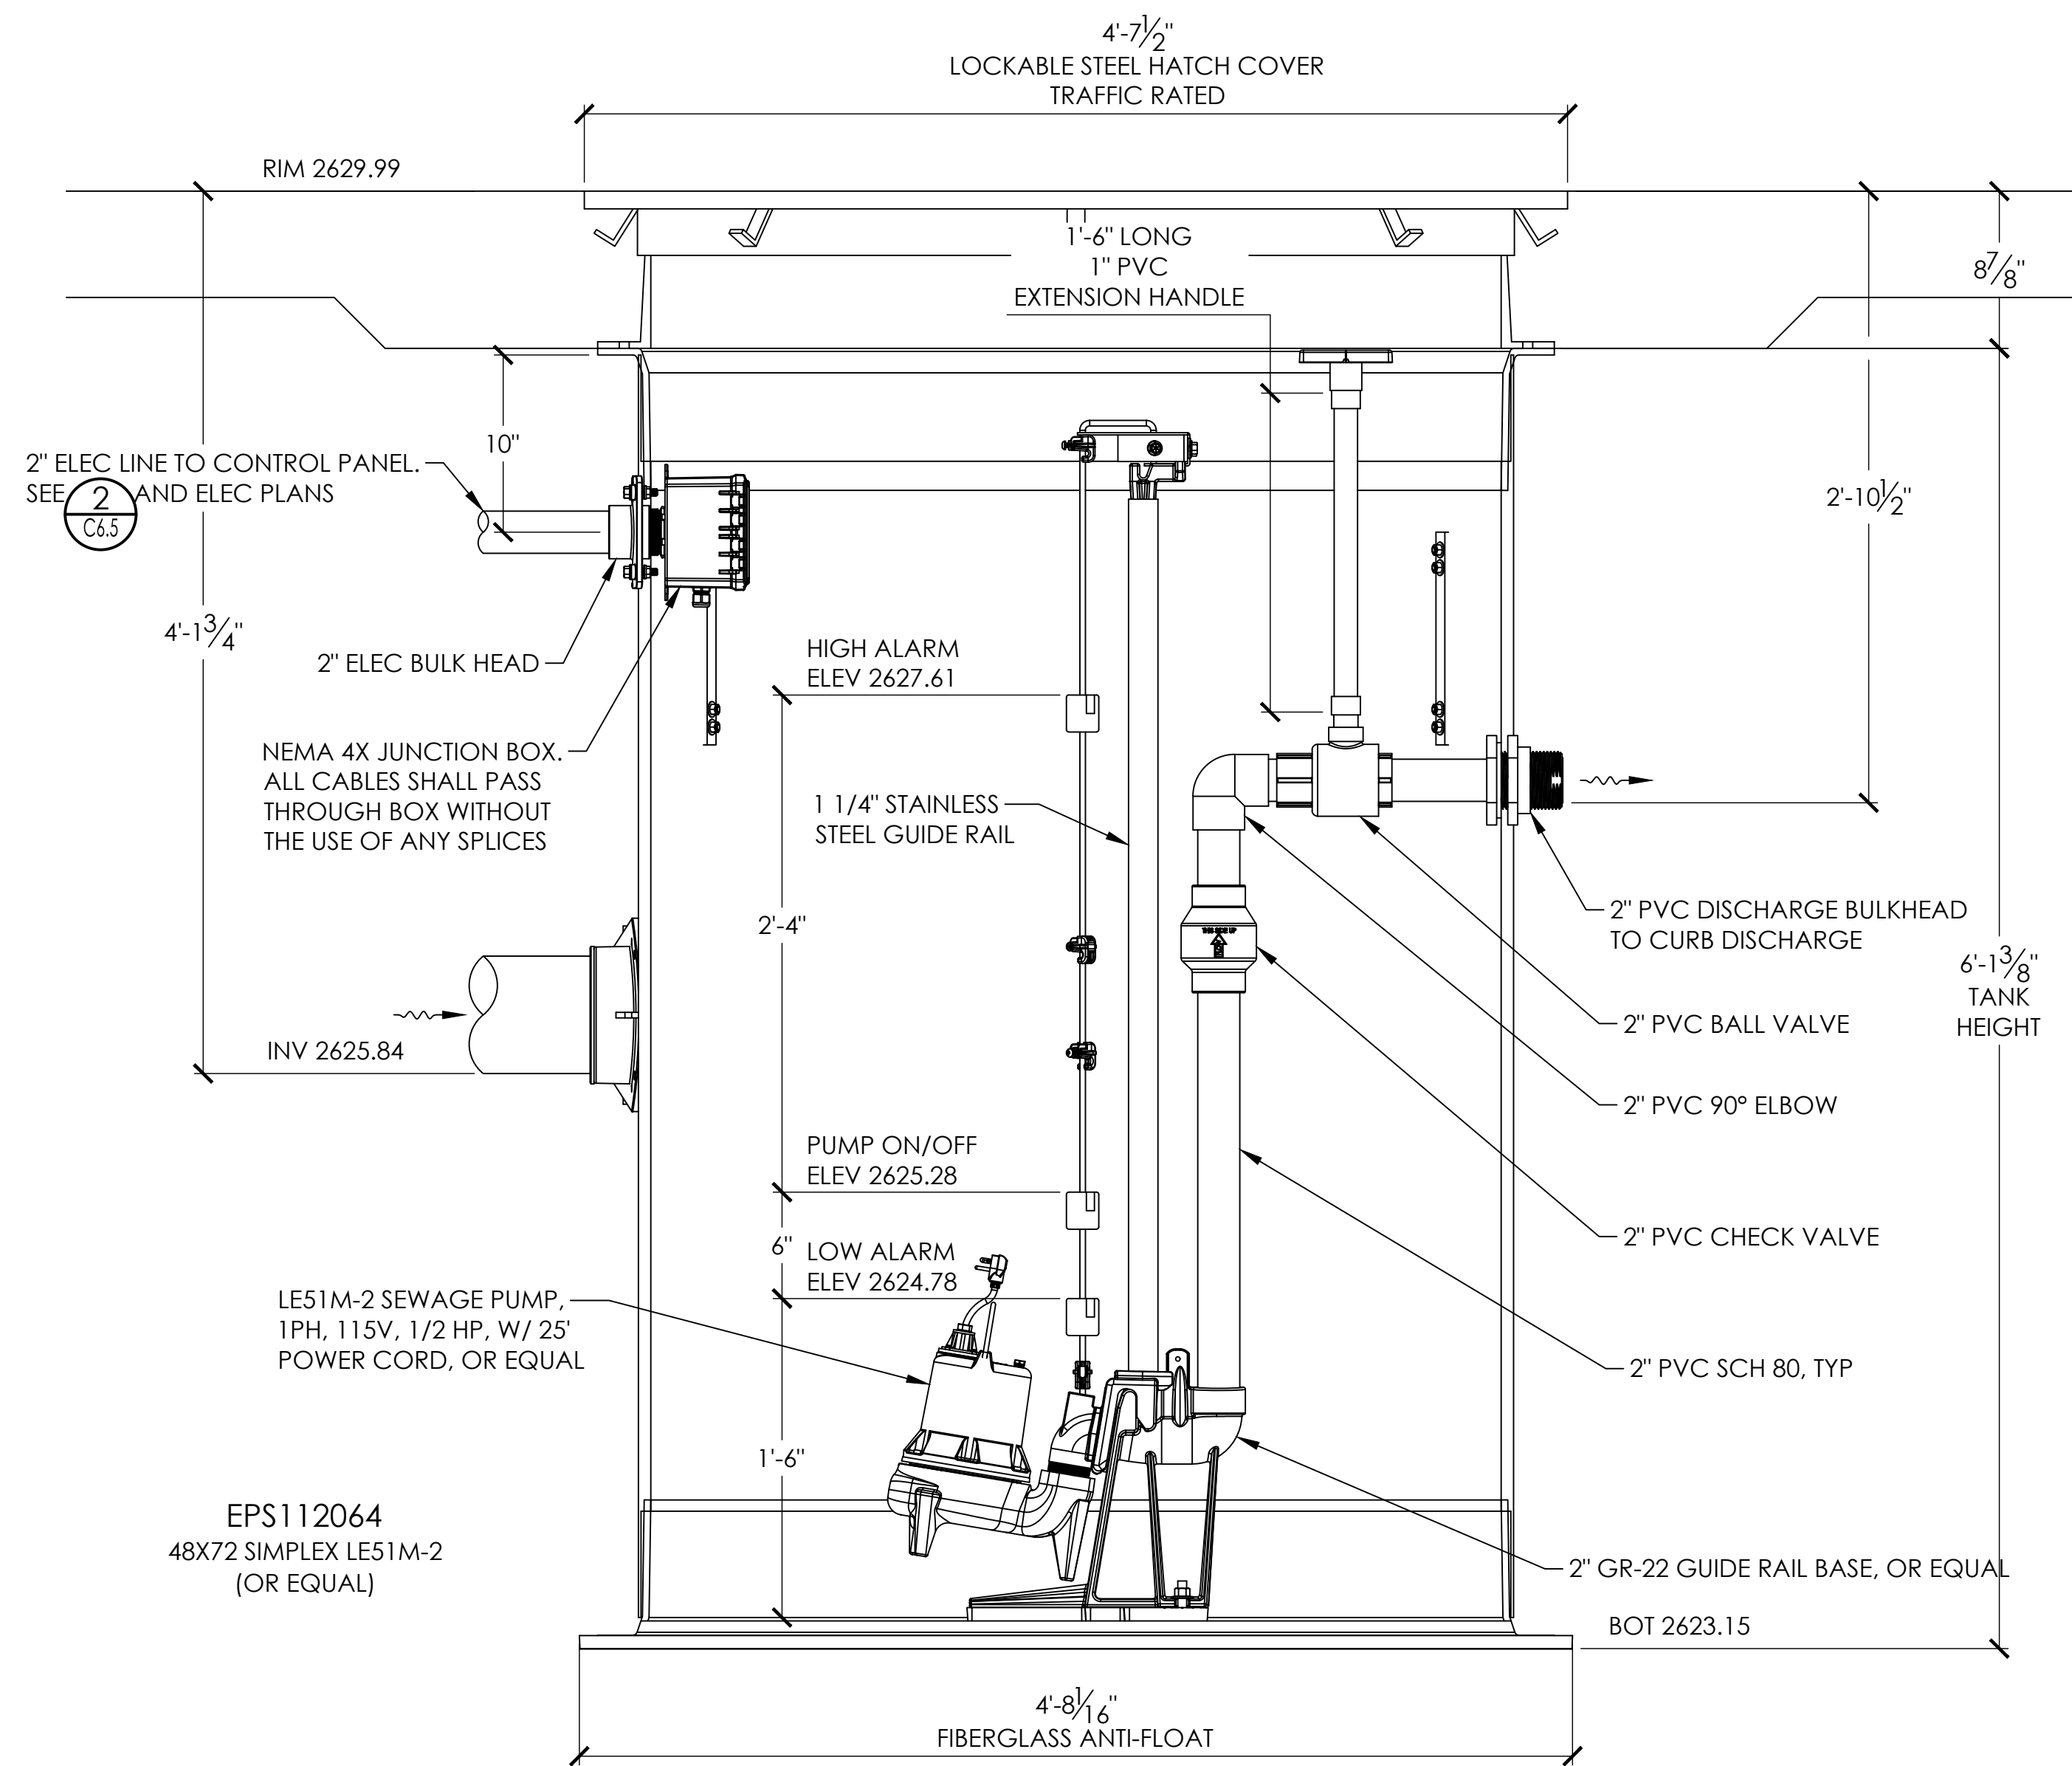

SUMP PUMP DETAIL 1 NTS C6.5

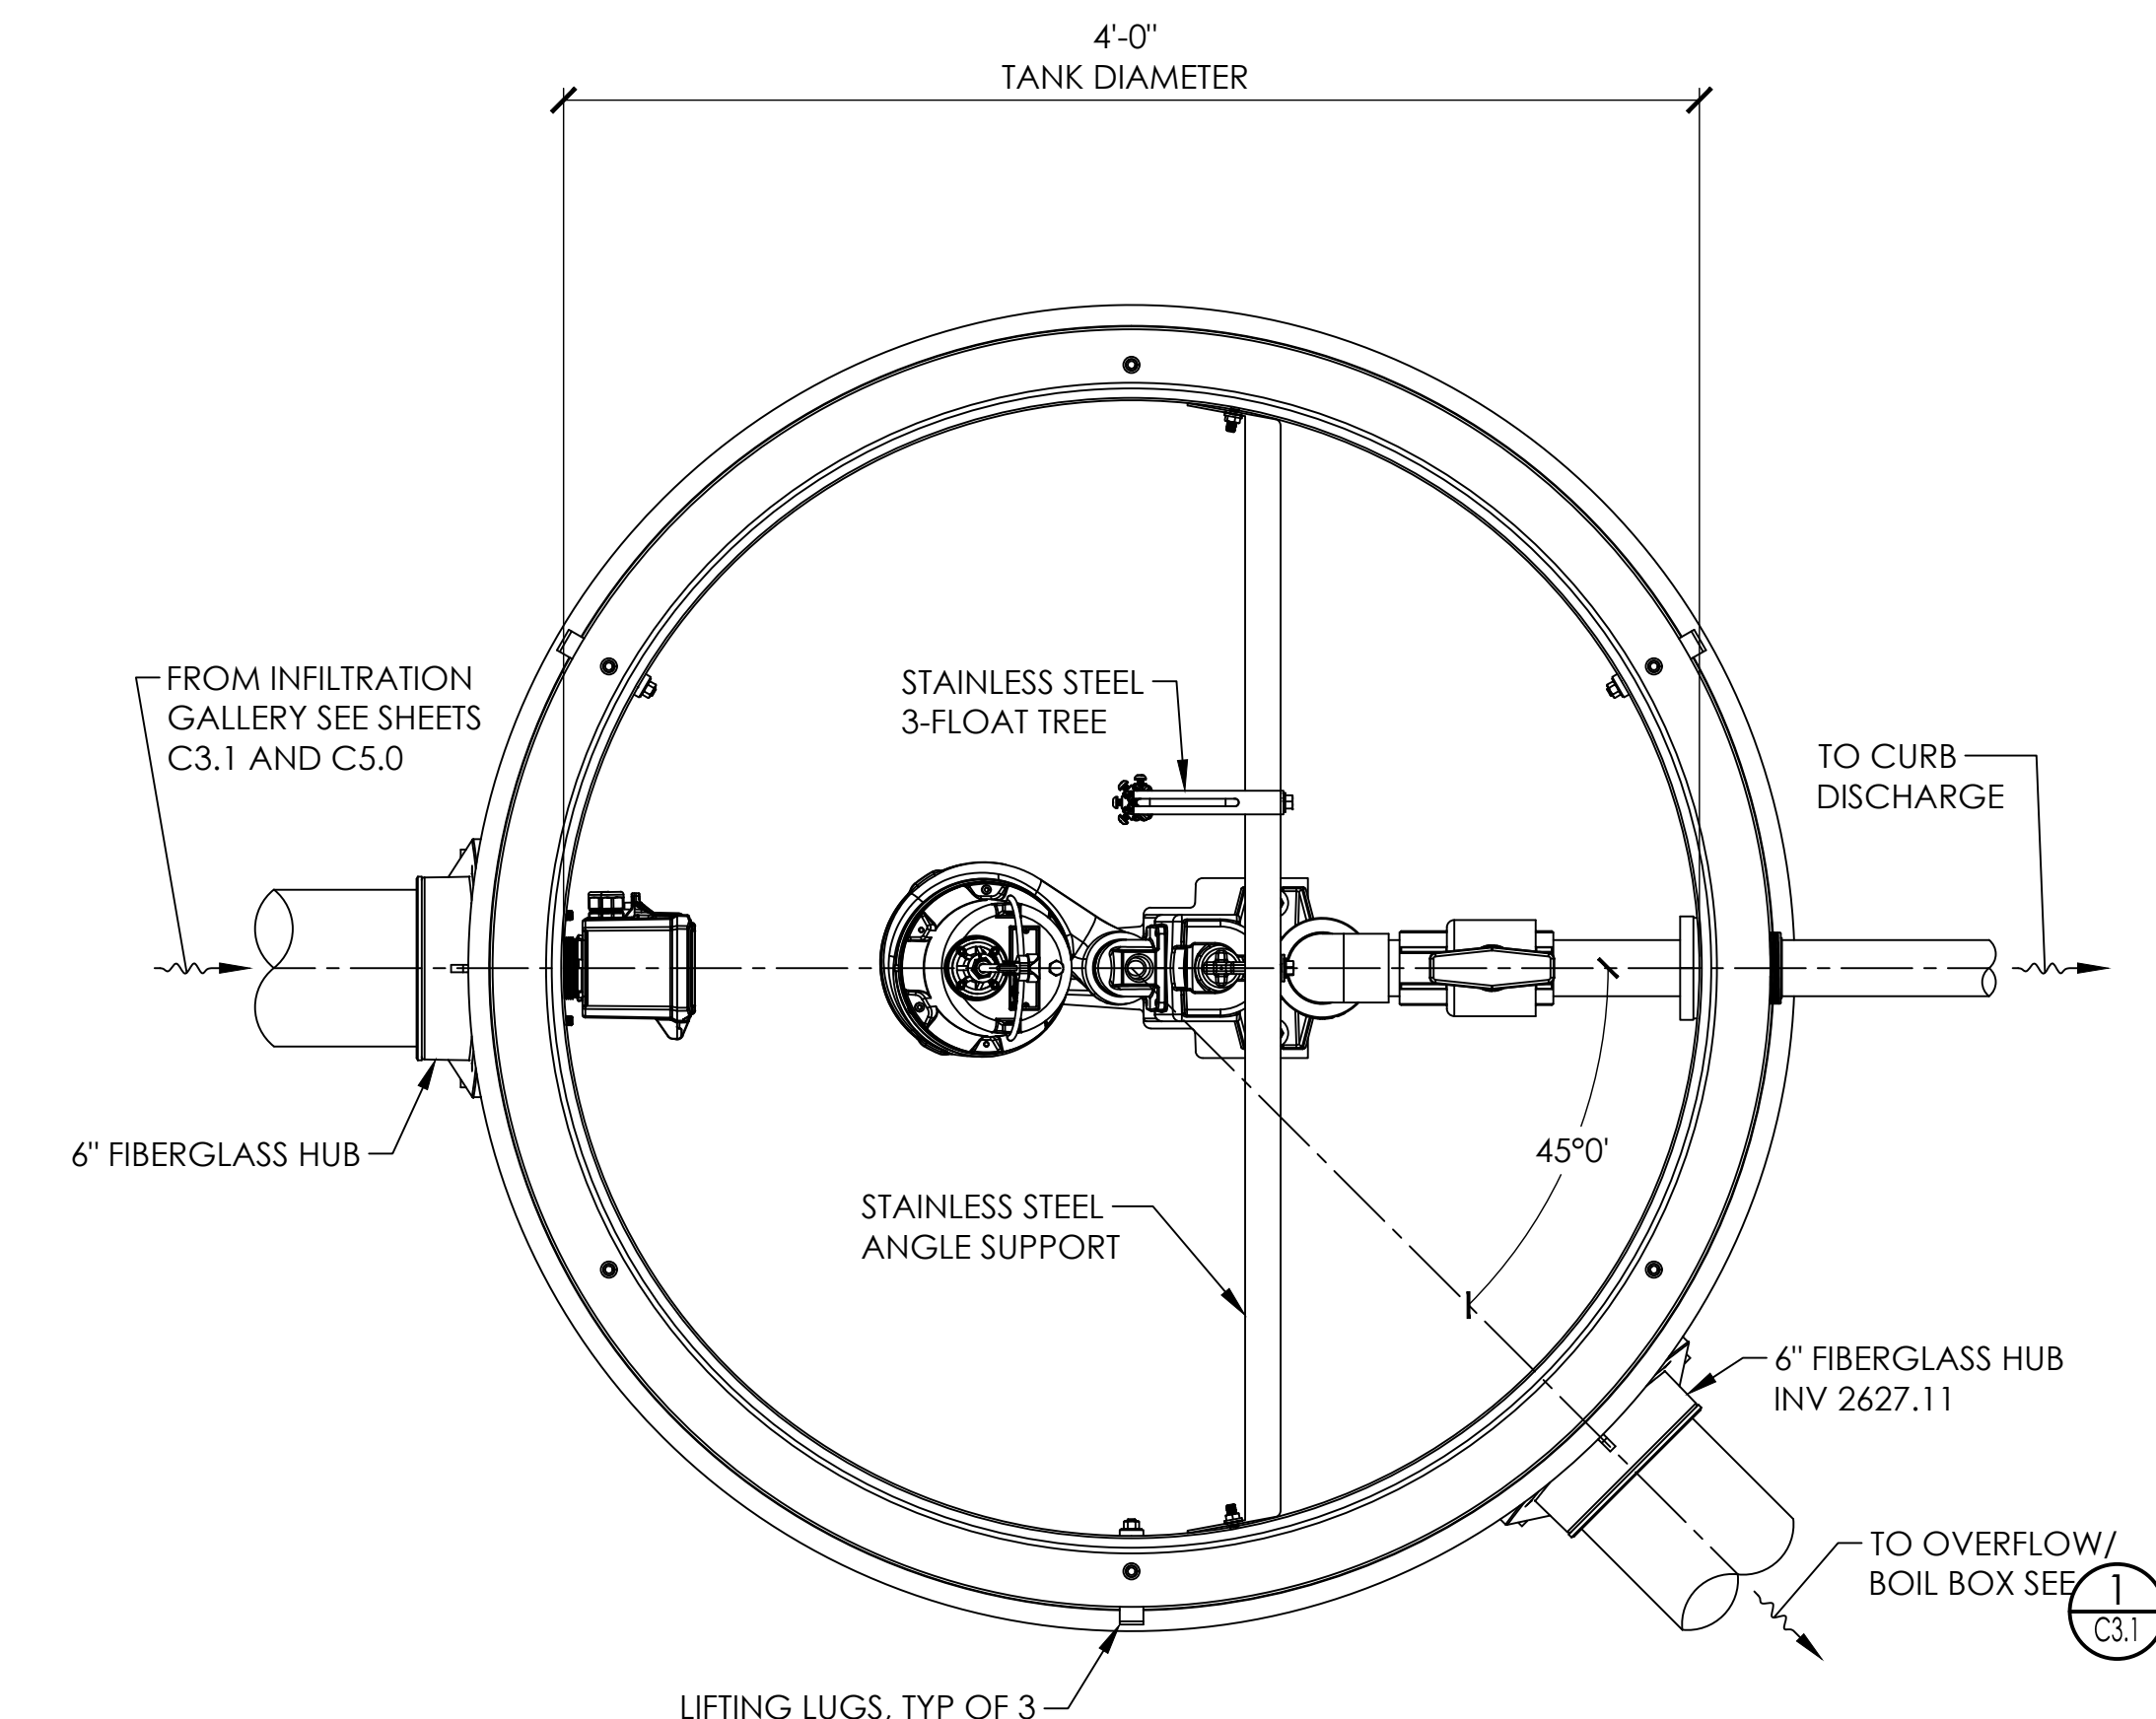

SUMP PUMP DETAIL 3 NTS C6.5

PERMIT SET

BAR IS ONE INCH ON ORIGINAL DRAWING
0" 1"
IF NOT ONE INCH ON THIS SHEET, ADJUST SCALES ACCORDINGLY.

REVISIONS		
NO	DATE	DESCRIPTION



DES: RT CKD: TJSWg JOB NO. DRN: RT DATE: 9/10/24 0470.22




SISKIYOU COUNTY GOVERNMENT CENTER PARKING LOT IMPROVEMENTS

SUMP PUMP DETAILS

SHEET
C6.5
PG 14 OF 17



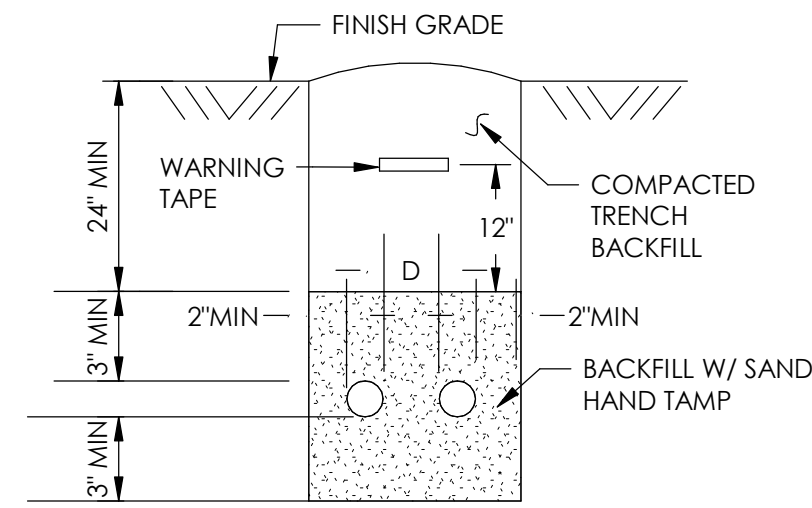

NOTES:



- D=3" MIN FOR 2" AND LARGER CONDUIT
- D=2" MIN FOR 1 1/2" AND SMALLER CONDUIT
- CONDUIT DETAIL FOR LESS THAN 4 RACEWAYS PER TRENCH.
- DUCT RUNS WITH 5 OR MORE CONDUITS SHALL EMPLOY DUCT SPACERS.

RACEWAY - UNDERGROUND CONDUIT 1
NTS EQ.1

(E) PANELBOARD GEN																
LOCATION		BOILER ROOM		VOLTS		120/208 WYE		BUS RATING		200 A						
MOUNTING TYPE		SURFACE		WIRES		4		MAIN BREAKER		200 A						
ENCLOSURE TYPE		NEMA 1		CIRCUITS		18				200 A						
CKT	HOME RUN	LOAD NAME	TRIP	INT TYPE	A	B	C	A	B	C	INT TYPE	TRIP	LOAD NAME	HOME RUN	CKT	
1	--	(E) SPACE	--	--	--	--	1440 VA	--	--	--	--	20 A	(N) STORM DRAIN PUMP	(N) 3/4"C-2#10,1#10G	2	
3	--	(E) SPACE	--	--	--	--	--	--	--	--	--	--	(N) SPACE	--	4	
5	--	(E) SPACE	--	--	--	--	--	--	--	--	--	--	(N) SPACE	--	6	
7					0 VA			0 VA							8	
9	EXISTING	(E) IT HVAC PNL	100 A	--		0 VA			0 VA		--	20 A	(E) GEN HTR & CHGR	EXISTING	10	
11															12	
13					0 VA			0 VA				50 A	(E) TELECOM RM PNL	EXISTING	14	
15	EXISTING	(E) IT PNL	125 A	--		0 VA			0 VA		--	20 A	(E) TELECOM RM HVAC	EXISTING	16	
17							0 VA			0 VA					18	
					PHASE A		PHASE B		PHASE C		Notes:					
TOTAL LOAD (VA)					1440 VA		0 VA		0 VA							
TOTAL LOAD (AMPS)					12		0		0							

#	NOTE
1	REMOVE EXISTING 125A/3P SPARE BREAKER AND REPLACE WITH NEW 20A BREAKER AND 2 SPACES. THE NEW CIRCUIT BREAKER SHALL BE OF THE SAME TYPE AND RATING AS EXISTING. UPDATE CIRCUIT DIRECTORY.
2	INSTALL NEW RMC CONDUIT ALONG SAME PATH AS EXISTING. UTILIZE EXISTING PENETRATIONS FOR NEW CONDUIT.
3	TRENCH TO WALL OF CONCRETE STRUCTURE AND CORE THROUGH CONCRETE. SEAL WALL PENETRATIONS AFTER CONDUIT INSTALLATION.
4	CAP CONDUIT TO PREVENT DEBRIS FROM ENTERING CONDUIT BETWEEN PHASES.
5	COUPLE NEW CONDUIT TO EXISTING AND EXTEND.
6	PROVIDE AND INSTALL WATER-TIGHT ENCLOSURE. LIBERTY PUMPS JB70, OR EQUAL SHALL BE UTILIZED. FLOAT AND PUMP CABLES SHALL BE SEALED WITH CABLE GLADS AT ENCLOSURE.
7	PROVIDE AND INSTALL PUMP CONTROL PANEL WITH HIGH LEVEL ALARMS. LIBERTY PUMPS SXL24-3 OR EQUAL SHALL BE UTILIZED. THE CONTROL PANEL SHALL BE MOUNTED TO THE BUILDING EXTERIOR.

#	NOTE
1	REFER TO CIVIL DRAWINGS FOR COMPLETE SUMP PUMP SCOPE OF WORK. CONDUIT ROUTING SHALL ALIGN WITH CIVIL DRAWINGS. PROVIDE AND INSTALL ALL PUMP ACCESSORIES REQUIRED FOR A COMPLETE INSTALLATION.
2	COORDINATE WITH CIVIL SCOPE OF WORK FOR PHASING. PHASE ONE IS IN PREPARATION FOR THE INSTALLATION OF THE SUMP PUMP. PHASE TWO WORK IS TO BE COMPLETED AFTER THE MAJORITY OF CIVIL WORK IS COMPLETED.

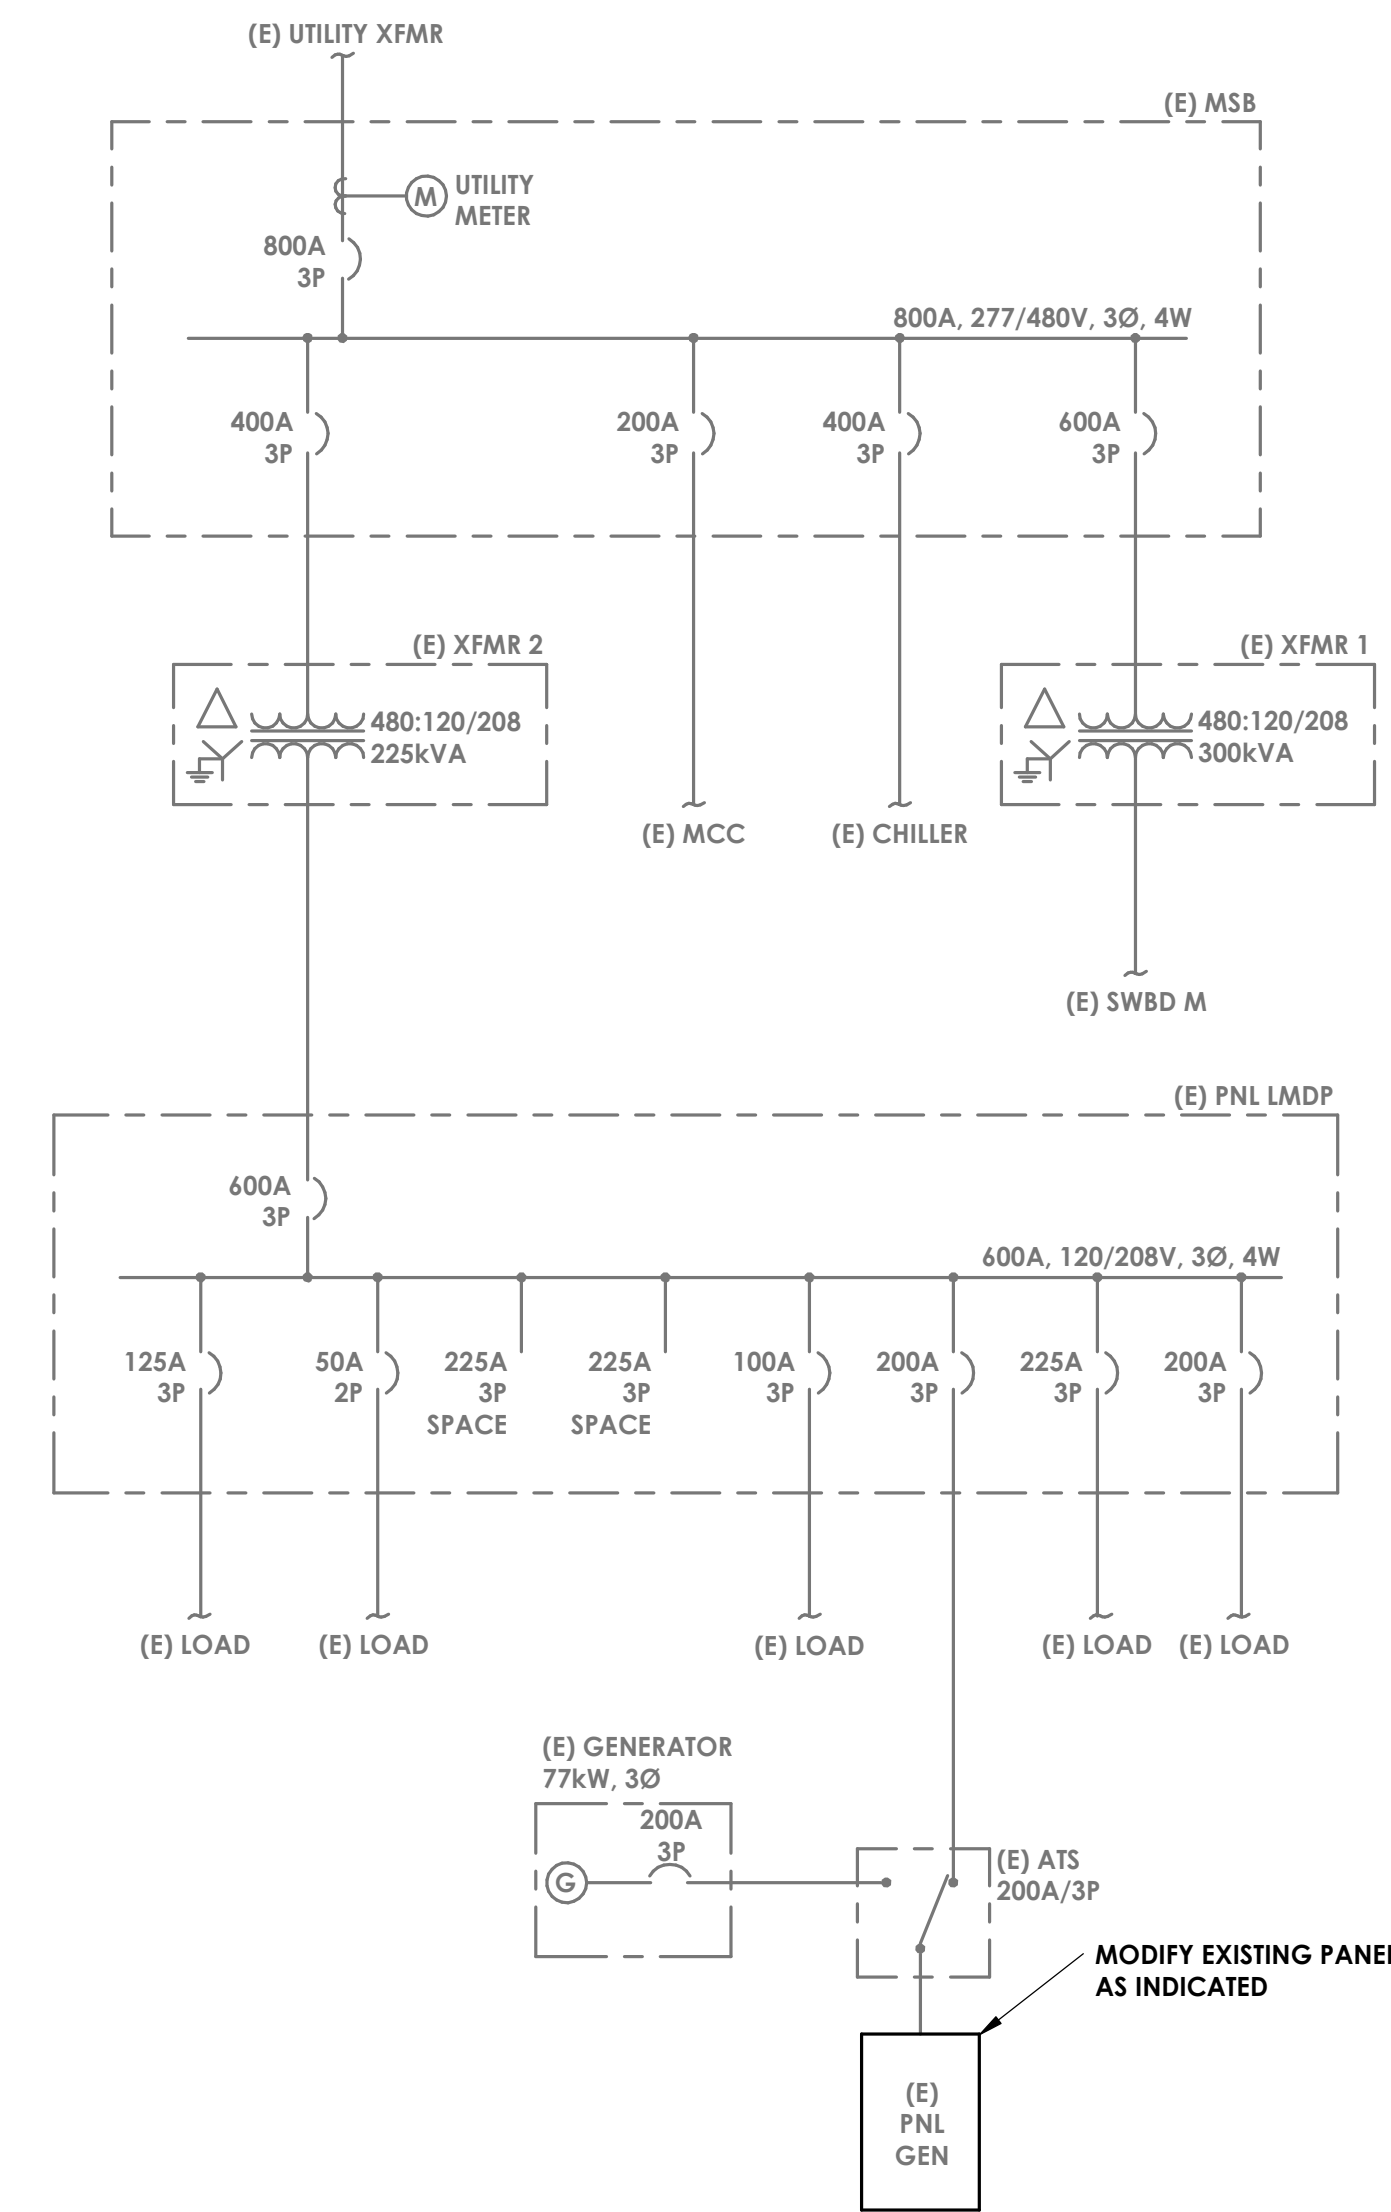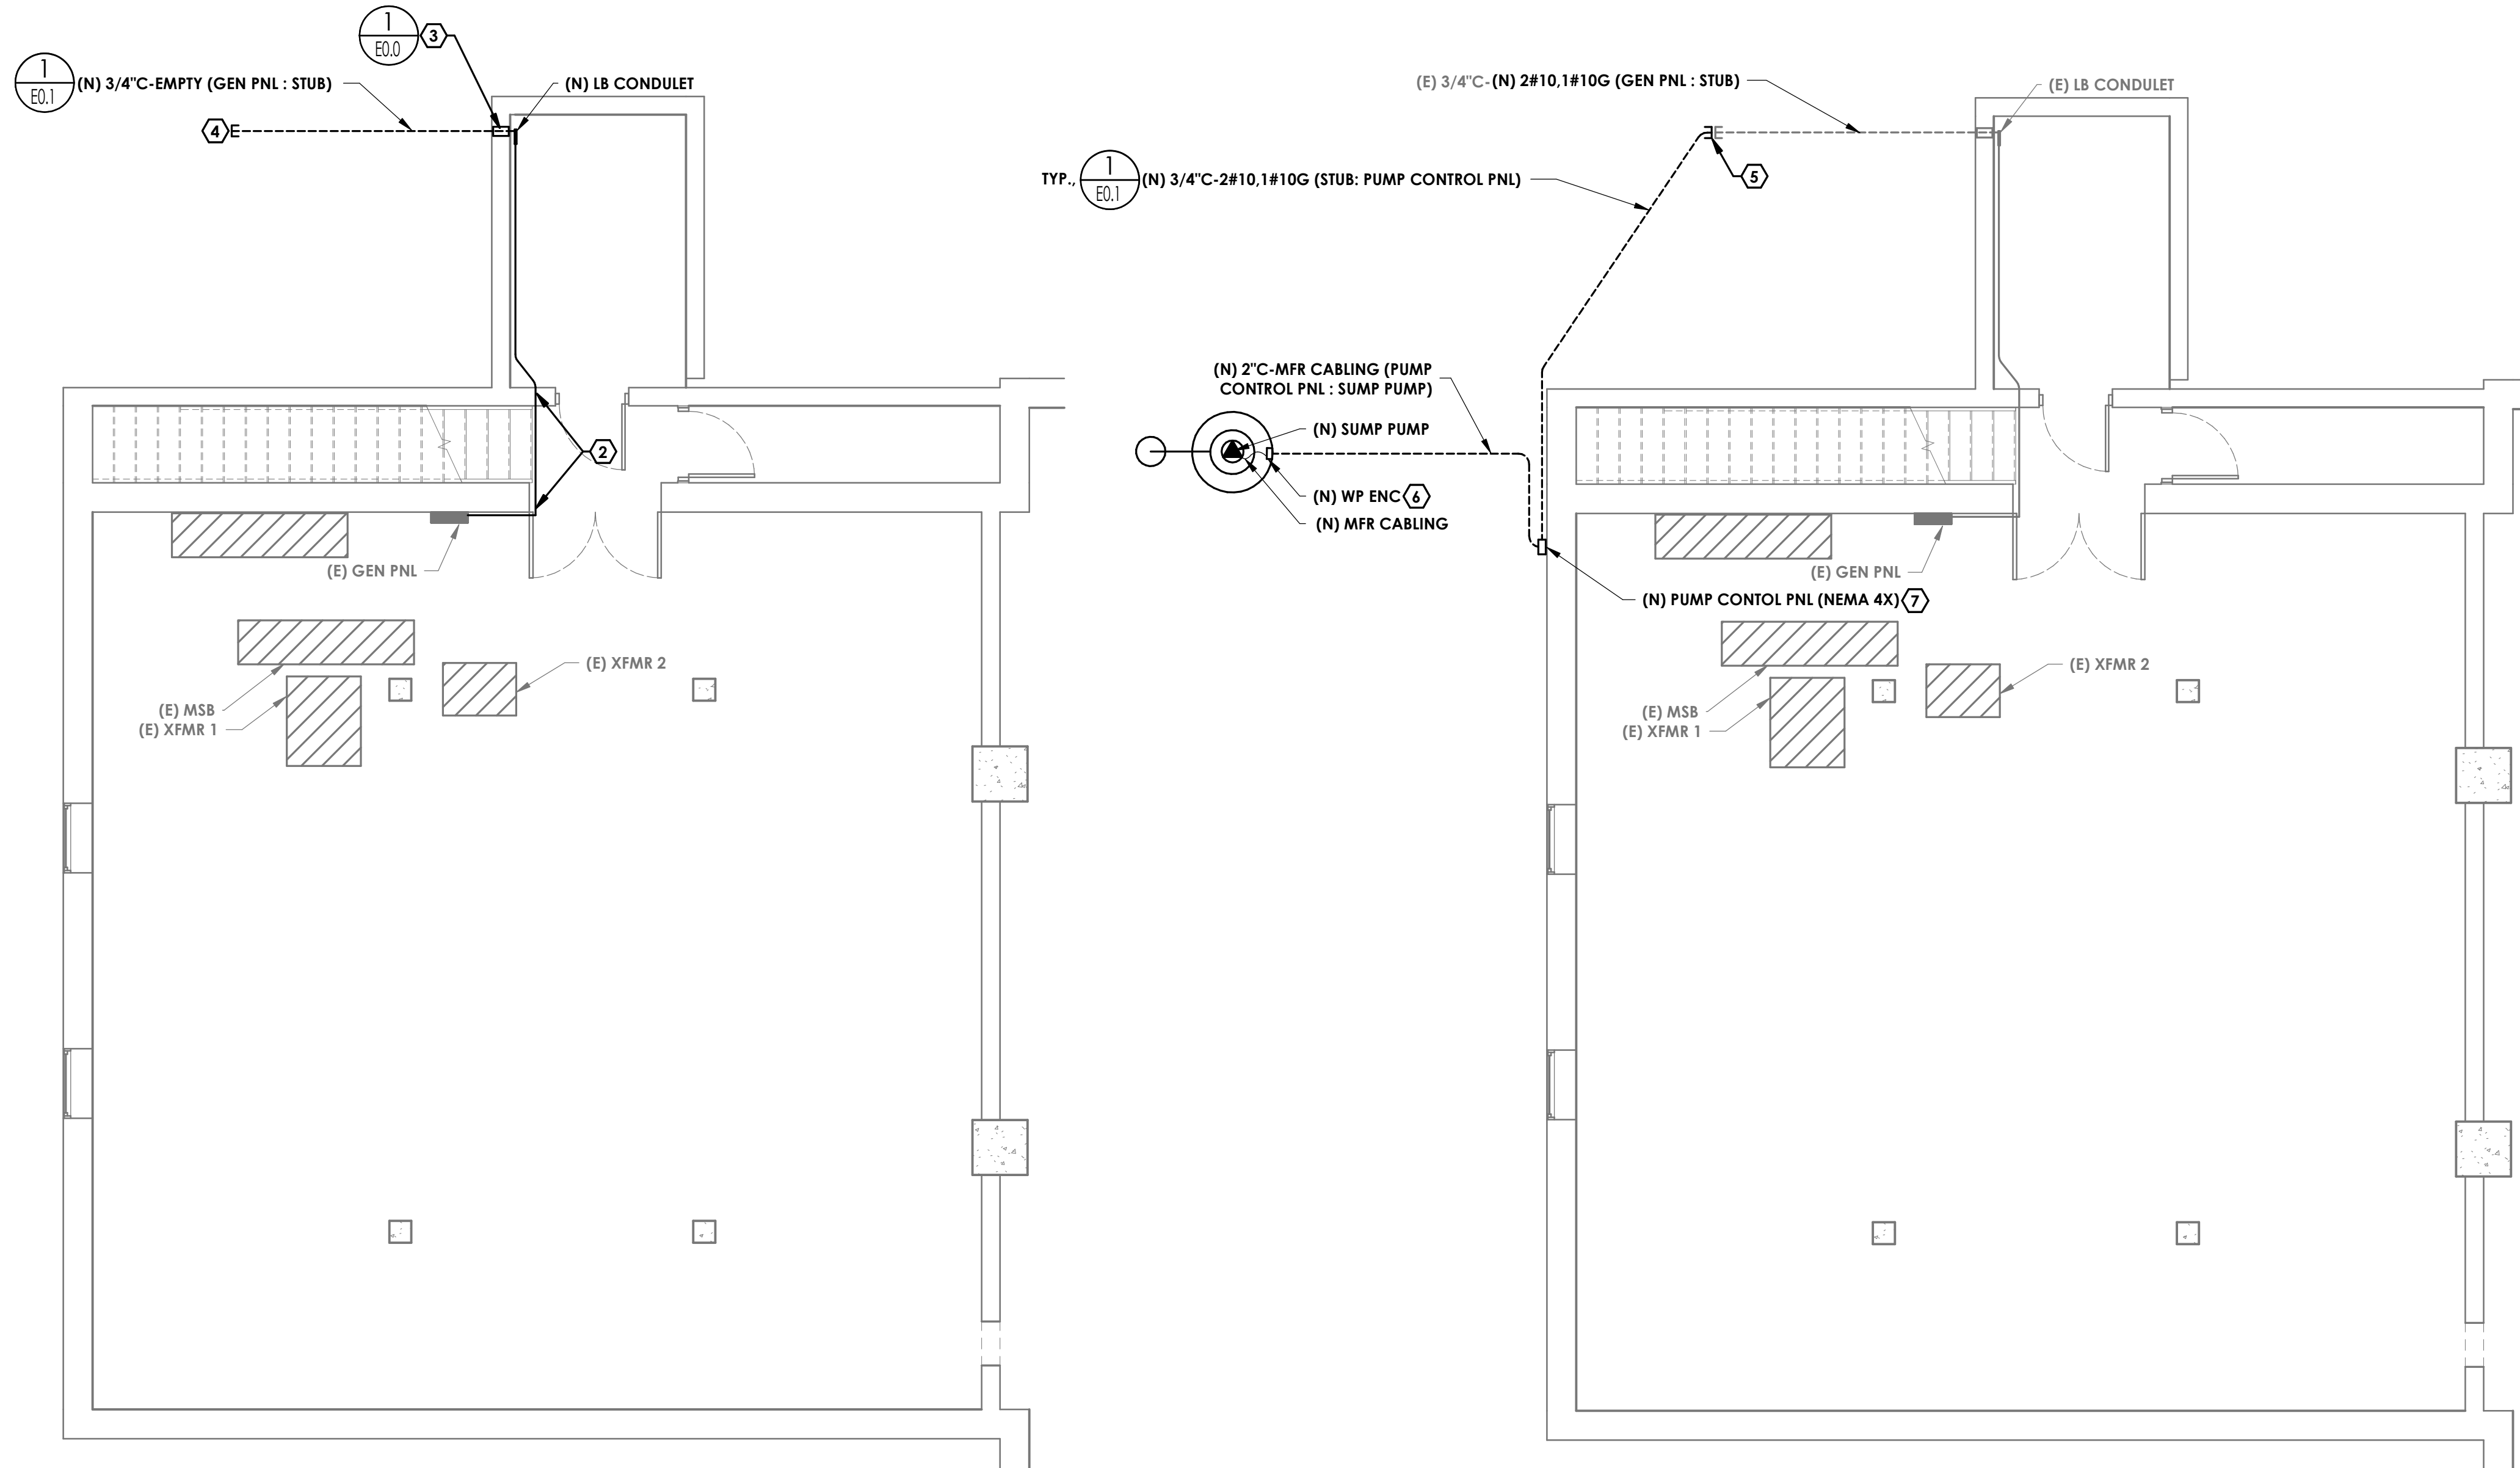

ELECTRICAL SITE PLAN - PHASE 1 2
3/16" = 1'-0" EQ.1


ELECTRICAL SITE PLAN - PHASE 2 3
3/16" = 1'-0" EQ.1

ONE-LINE DIAGRAM 4
EQ.1

BAR IS ONE INCH ON ORIGINAL DRAWING
0" 1"
IF NOT ONE INCH ON THIS SHEET, ADJUST SCALES ACCORDINGLY

REVISIONS		
NO	DATE	DESCRIPTION

PACE ENGINEERING
DES NP/DB CKD TB JOB NO.
DRN DB DATE 7/26/20 0470.22

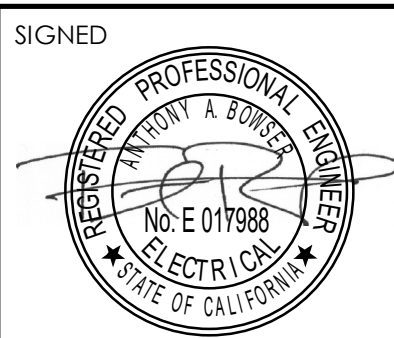

SISKIYOU COUNTY GOVERNMENT CENTER
PARKING LOT IMPROVEMENTS
ONE-LINE DIAGRAM & ELECTRICAL PLANS

SHEET
E0.1
PG 16 OF 17

CERTIFICATE OF COMPLIANCE NRCC-ELC-E
 This document is used to demonstrate compliance with mandatory requirements in 130.5, for electrical systems in newly constructed nonresidential and hotel/motel occupancies and 160.6 and 160.9 for electrical systems in newly constructed multifamily occupancies. Additions and alterations to electrical service systems in nonresidential and hotel/motel occupancies will also use this document to demonstrate compliance per 141.0(a) or 141.0(b) for alterations. For multifamily addition or alterations compliance will be documented per 180.1(a) or 180.2 (b)4Biv.
 Project Name: Government Center ADA Parking Report Page: (Page 1 of 4)
 Project Address: 311 4th St, Yreka, CA 96097 Date Prepared: 2024-07-23T17:36:29-04:00

A. GENERAL INFORMATION

01	Project Location (city)	Yreka	02	Climate Zone	16
03	Occupancy Types Within Project:		04	Office	

B. PROJECT SCOPE
 This table includes electrical systems that are within the scope of the permit application.

01	02	03	04	05	06	07
Electrical Service Designation/Description	Scope of Work ¹	Rating ² (kVA)	Utility Provided Exception to 130.5(a)/160.6(a) ³	System subject to CA Elec Code Article 517 Exception to 130.5(a) and (b)	Demand Response Controls	Provides power to dwelling units/common living areas only in multifamily occupancy
E0.2	Add/Alt to feeders and branch circuits only	---	<input type="checkbox"/>	<input type="checkbox"/>	Where required, demand response controls must be specified which are capable of receiving and automatically responding to at least one standards based messaging protocol which enables demand response after receiving a demand response signal. Sections 120.2/ 160.3, 130.1/ 160.5, and 130.3/ 160.5, and mechanical, indoor lighting, and sign lighting Certificate of Compliance documents will indicate when demand response controls are required.	<input type="checkbox"/>

¹ FOOTNOTES: Adding only new feeders and branch circuits triggers Voltage Drop 130.5(c)/160.6(c), no other requirements from 130.5/160.6 are required.
² If common use areas in a multifamily are submetered, rating is for submeter size serving common use areas.
³ Applicable if the utility company is providing a metering system that indicates instantaneous kW demand and kWh for a utility-defined period.

Generated Date/Time: Documentation Software: Energy Code Ace
 Report Version: 2022.0.000 Compliance ID: 214144-0724-0003
 Schema Version: rev 20220101 Report Generated: 2024-07-23 14:36:31

CERTIFICATE OF COMPLIANCE NRCC-ELC-E
 Project Name: Government Center ADA Parking Report Page: (Page 3 of 4)
 Project Address: 311 4th St, Yreka, CA 96097 Date Prepared: 2024-07-23T17:36:29-04:00

K. DECLARATION OF REQUIRED CERTIFICATES OF INSTALLATION
 Selections have been made based on information provided in this document. If any selection have been changed by permit applicant, an explanation should be included in Table E. Additional Remarks. These documents must be provided to the building inspector during construction and can be found online.

Form/Title
NRCC-ELC-E - Must be submitted for all buildings

L. DECLARATION OF REQUIRED CERTIFICATES OF ACCEPTANCE
 There are no forms required for this project.

Generated Date/Time: Documentation Software: Energy Code Ace
 Report Version: 2022.0.000 Compliance ID: 214144-0724-0003
 Schema Version: rev 20220101 Report Generated: 2024-07-23 14:36:31

CERTIFICATE OF COMPLIANCE NRCC-ELC-E
 Project Name: Government Center ADA Parking Report Page: (Page 2 of 4)
 Project Address: 311 4th St, Yreka, CA 96097 Date Prepared: 2024-07-23T17:36:29-04:00

C. COMPLIANCE RESULTS
 Results in this table are automatically calculated from data input and calculations in Tables F through J. Note: If any cell on this table says "COMPLIES with Exceptional Conditions" refer to Table D. Exceptional Conditions for guidance or see applicable Table referenced below.

01	02	03	04	05	06				
Service Electrical Metering 130.5(a)/160.6(a) (See Table F)	AND	Separation for Monitoring 130.5(b)/160.6(b) (See Table G)	AND	Voltage Drop 130.5(c)/160.6(c) (See Table H)	AND	Controlled Receptacles 130.5(d)/160.6(d) (See Table I)	AND	Electric Ready 160.9 (See Table J)	Compliance Results
	AND		AND	Yes	AND				COMPLIES

D. EXCEPTIONAL CONDITIONS
 This table is auto-filled with uneditable comments because of selections made or data entered in tables throughout the form.

E. ADDITIONAL REMARKS
 This table includes remarks made by the permit applicant to the Authority Having Jurisdiction.

H. VOLTAGE DROP
 This table includes entirely new or complete replacement electrical power distribution systems, or alterations that add, modify or replace both feeders and branch circuits to demonstrate compliance with 130.5(c)/160.6(c). For alterations, only the altered circuits must demonstrate compliance per 141.0(b)2Piii/180.2(b)4Bivc.

01	02	03	04	05
Electrical Service Designation/Description	Combined Voltage Drop on Installed Feeder/Branch Circuit Conductors Compliance Method	Location of Voltage Drop Calculations ¹	Sheet Number for Voltage Drop Calculations in Construction Documents	Field Inspector Pass Fail
E0.2	<input checked="" type="checkbox"/> Voltage drop less than 5%	<input type="checkbox"/> Permitted by CA Elec Code (Exception to 130.5(c))*	In construction documents	E1.0 <input type="checkbox"/> <input type="checkbox"/>

* NOTES: If "Permitted by CA Elec Code *" is selected under Compliance Method above, please indicate where the exception applies in the space provided below.
¹ FOOTNOTES: Voltage drop calculations may be attached to the permit application outside the construction documents if allowed by the Authority Having Jurisdiction. Select "attached" if applicable. If calculations will be the responsibility of the installing contractor, select "Contractor Responsible".

Generated Date/Time: Documentation Software: Energy Code Ace
 Report Version: 2022.0.000 Compliance ID: 214144-0724-0003
 Schema Version: rev 20220101 Report Generated: 2024-07-23 14:36:31

CERTIFICATE OF COMPLIANCE NRCC-ELC-E
 Project Name: Government Center ADA Parking Report Page: (Page 4 of 4)
 Project Address: 311 4th St, Yreka, CA 96097 Date Prepared: 2024-07-23T17:36:29-04:00

DOCUMENTATION AUTHOR'S DECLARATION STATEMENT
 I certify that this Certificate of Compliance documentation is accurate and complete.

Documentation Author Name: Anthony Bowsler
 Company: PACE Engineering Inc
 Address: 5155 Venture Pkwy
 City/State/cip: Redding, CA 96002
 Phone: 530 244 0202

RESPONSIBLE PERSON'S DECLARATION STATEMENT
 I certify the following under penalty of perjury under the laws of the State of California:
 1. The information provided on this Certificate of Compliance is true and correct.
 2. I am eligible under Division 3 of the Business and Professions Code to accept responsibility for the building design or system design identified on this Certificate of Compliance (responsible designer).
 3. The energy features and performance specifications, materials, components, and manufactured devices for the building design or system design identified on this Certificate of Compliance conform to the requirements of Title 24, Part 1 and Part 6 of the California Code of Regulations.
 4. The building design features or system design features identified on this Certificate of Compliance are consistent with the information provided on other applicable compliance documents, worksheets, calculations, plans and specifications submitted to the enforcement agency for approval with this building permit application.
 5. I will ensure that a completed signed copy of this Certificate of Compliance shall be made available with the building permit(s) issued for the building, and made available to the enforcement agency for all applicable inspections. I understand that a completed signed copy of this Certificate of Compliance is required to be included with the documentation the builder provides to the building owner at occupancy.

Responsible Designer Name: Anthony Bowsler
 Company: PACE Engineering Inc
 Address: 5155 Venture Pkwy
 City/State/cip: Redding, CA 96002
 License: E 017888
 Phone: 530 244 0202

Generated Date/Time: Documentation Software: Energy Code Ace
 Report Version: 2022.0.000 Compliance ID: 214144-0724-0003
 Schema Version: rev 20220101 Report Generated: 2024-07-23 14:36:31


VOLTAGE DROP CALCULATIONS

DISTRIBUTION	LOAD TYPE	CONDUIT MATERIAL	CONDUCTOR MATERIAL	QUANTITY OF RUNS	CONDUCTOR SIZE (AWG)	CURRENT (A)	DISTANCE (FT)	VOLTAGE (V)	IMPEDANCE (Z)	VOLTAGE DROP (VD)	VOLTAGE DROP (%)
MSB : XFMR 2	LINE-LINE (3Ø)	EMT	CU	1	500	320	10	480	0.05	0.27	0.06%
XFMR 2 : PNL LMDP	LINE-LINE (3Ø)	EMT	CU	2	350	480	10	208	0.03	0.24	0.12%
PNL LMDP : ATS	LINE-LINE (3Ø)	EMT	CU	1	3/0	160	15	208	0.09	0.38	0.18%
ATS : PNL GEN	LINE-LINE (3Ø)	EMT	CU	3/0	160	8	208	0.09	0.20	0.10%	
PNL GEN : PUMP	LINE-NEUTRAL	EMT	CU	1	10	15	75	120	1.10	1.24	1.03%
TOTAL VOLTAGE DROP:											1.48%
LINE-NEUTRAL	VD = (L * Z * I) / 1000		LINE-LINE (3Ø)	VD = (SQRT(3) * L * X * I) / 1000		L = DISTANCE		Z = IMPEDANCE			
LINE-LINE (1Ø)	VD = (2 * L * Z * I) / 1000				I = CURRENT		VD = VOLTAGE DROP				

BAR IS ONE INCH ON ORIGINAL DRAWING
 0" 1"
 IF NOT ONE INCH ON THIS SHEET, ADJUST SCALES ACCORDINGLY

REVISIONS

NO	DATE	DESCRIPTION

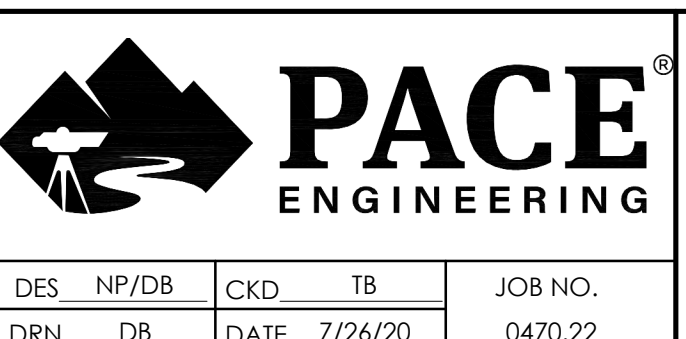

SIGNED
 ANTHONY A. BOWSLER
 REGISTERED PROFESSIONAL ENGINEER
 No. E 017888
 STATE OF CALIFORNIA

SISKIYOU COUNTY GOVERNMENT CENTER
 PARKING LOT IMPROVEMENTS
 TITLE 24 ELECTRICAL COMPLIANCE DOCUMENTS

SHEET
E1.0
 PG 17 OF 17